


MW-2

1 LOCATION OF WATER WELL: County: **Wilson** Fraction: **NE 1/4 SW 1/4 SW 1/4** Section Number: **20** Township Number: **T 30 S** Range Number: **R 16 EW**

Distance and direction from nearest town or city street address of well if located within city?

2 WATER WELL OWNER: RR#, St. Address, Box #: **Greaves Mini Mart Attn: Norm Castagna** Board of Agriculture, Division of Water Resources
 City, State, ZIP Code: **825 Main, Neodesha, Kansas** Application Number: **-----**

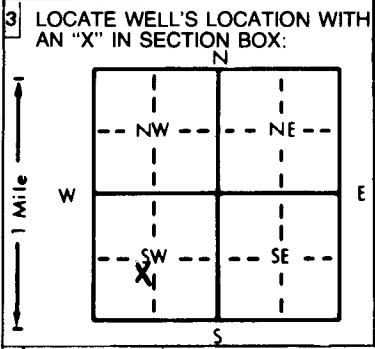

4 DEPTH OF COMPLETED WELL: **19** ft. ELEVATION: **-----**
 Depth(s) Groundwater Encountered 1. **13** ft. 2. **-----** ft. 3. **-----** ft.
 WELL'S STATIC WATER LEVEL: **10.91** ft. below land surface measured on mo/day/yr
 Pump test data: Well water was **-----** ft. after **-----** hours pumping **-----** gpm
 Est. Yield **-----** gpm: Well water was **-----** ft. after **-----** hours pumping **-----** gpm
 Bore Hole Diameter: **8.625** in. to **19** ft. and **-----** in. to **-----** ft.
 WELL WATER TO BE USED AS: 5 Public water supply 8 Air conditioning 11 Injection well
 1 Domestic 3 Feedlot 6 Oil field water supply 9 Dewatering 12 Other (Specify below)
 2 Irrigation 4 Industrial 7 Lawn and garden only **10 Monitoring well MW-2**
 Was a chemical/bacteriological sample submitted to Department? Yes **-----** No **X**; If yes, mo/day/yr sample was submitted **-----**
 Water Well Disinfected? Yes **-----** No **X**

5 TYPE OF BLANK CASING USED: 1 Steel 3 RMP (SR) 5 Wrought iron 8 Concrete tile CASING JOINTS: Glued **-----** Clamped **-----**
 2 PVC 4 ABS 6 Asbestos-Cement 9 Other (specify below) Welded **-----**
 Blank casing diameter: **2** in. to **9** ft. Dia. **-----** in. to **-----** ft. Dia. **-----** in. to **-----** ft.
 Casing height above land surface: **0** in., weight: **SCH 40 PVC** lbs./ft. Wall thickness or gauge No. **-----**
 TYPE OF SCREEN OR PERFORATION MATERIAL: 7 PVC 10 Asbestos-cement
 1 Steel 3 Stainless steel 5 Fiberglass 8 RMP (SR) 11 Other (specify) **-----**
 2 Brass 4 Galvanized steel 6 Concrete tile 9 ABS 12 None used (open hole)
 SCREEN OR PERFORATION OPENINGS ARE: 5 Gauzed wrapped 8 Saw cut 11 None (open hole)
 1 Continuous slot 3 Mill slot 6 Wire wrapped 9 Drilled holes
 2 Louvered shutter 4 Key punched 7 Torch cut 10 Other (specify) **-----**
 SCREEN-PERFORATED INTERVALS: From **9** ft. to **19** ft. From **-----** ft. to **-----** ft.
SAND From **-----** ft. to **-----** ft. From **-----** ft. to **-----** ft.
GRAVEL PACK INTERVALS: From **8** ft. to **19** ft. From **-----** ft. to **-----** ft.
 From **-----** ft. to **-----** ft. From **-----** ft. to **-----** ft.

6 GROUT MATERIAL: 1 Neat cement 2 Cement grout 3 Bentonite 4 Other **-----**
 Grout Intervals: From **20** ft. to **6** ft. From **6** ft. to **8** ft. From **-----** ft. to **-----** ft.
 What is the nearest source of possible contamination: 10 Livestock pens 14 Abandoned water well
 1 Septic tank 4 Lateral lines 7 Pit privy 11 Fuel storage 15 Oil well/Gas well
 2 Sewer lines 5 Cess pool 8 Sewage lagoon 12 Fertilizer storage 16 Other (specify below) **contaminated site**
 3 Watertight sewer lines 6 Seepage pit 9 Feedyard 13 Insecticide storage
 Direction from well? **How many feet?**

FROM	TO	LITHOLOGIC LOG	FROM	TO	PLUGGING INTERVALS
GL	1.00	Soil			
	1.00	9.50			
		Clay w/Silt (CL)			
	9.50	19.00			
		Sandy Silt (ML)			
	19.00	TD			
		End of Borehole			

D. Taylor
 Flush Mount Wai
 12/27/96

7 CONTRACTOR'S OR LANDOWNER'S CERTIFICATION: This water well was **(1) constructed**, **(2) reconstructed**, or **(3) plugged** under my jurisdiction and was completed on (mo/day/year) **4-30-97** and this record is true to the best of my knowledge and belief. Kansas Water Well Contractor's License No. **585** This Water Well Record was completed on (mo/day/yr) **5-12-97** under the business name of **NEI** by (signature) **D. Taylor**

OFFICE USE ONLY
 T
 R
 EW
 SEC.
 1/4
 1/4
 1/4