


MW-1

1 LOCATION OF WATER WELL: County: **Wilson** Fraction: **NE 1/4 SW 1/4 SW 1/4** Section Number: **20** Township Number: **T 30 S** Range Number: **R 16 E/W**

Distance and direction from nearest town or city street address of well if located within city?

2 WATER WELL OWNER: RR#, St. Address, Box #: **Greaves Mini Mart Attn: Norm Castagna** Board of Agriculture, Division of Water Resources
 City, State, ZIP Code: **825 Main, Neodesha, Kansas** Application Number: **-----**

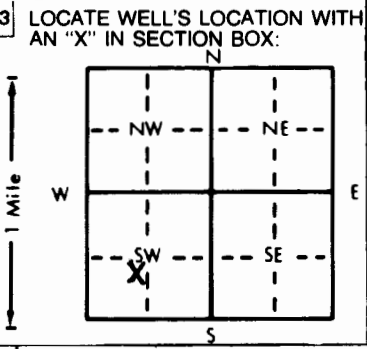

4 DEPTH OF COMPLETED WELL: **18** ft. ELEVATION: **-----**
 Depth(s) Groundwater Encountered 1. **13** ft. 2. **-----** ft. 3. **-----** ft.
 WELL'S STATIC WATER LEVEL: **11.25** ft. below land surface measured on **mo/day/yr 4-30-97**
 Pump test data: Well water was **-----** ft. after **-----** hours pumping **-----** gpm
 Est. Yield **-----** gpm: Well water was **-----** ft. after **-----** hours pumping **-----** gpm
 Bore Hole Diameter: **8.625** in. to **18** ft., and **-----** in. to **-----** ft.
 WELL WATER TO BE USED AS:
 1 Domestic 3 Feedlot 6 Oil field water supply 9 Dewatering 12 Other (Specify below)
 2 Irrigation 4 Industrial 7 Lawn and garden only 10 Monitoring well **MW-1**
 Was a chemical/bacteriological sample submitted to Department? Yes No **X**; If yes, mo/day/yr sample was submitted **-----**
 Water Well Disinfected? Yes No **X**

5 TYPE OF BLANK CASING USED:
 1 Steel 3 RMP (SR) 6 Asbestos-Cement 9 Other (specify below)
 2 PVC 4 ABS 7 Fiberglass CASING JOINTS: Glued Clamped
 Blank casing diameter: **2** in. to **8** ft., Dia. **-----** in. to **-----** ft., Dia. **-----** in. to **-----** ft.
 Casing height above land surface: **0** in., weight **SCH 40 PVC** lbs./ft. Wall thickness or gauge No. **-----**
 TYPE OF SCREEN OR PERFORATION MATERIAL:
 1 Steel 3 Stainless steel 5 Fiberglass 8 RMP (SR) 11 Other (specify)
 2 Brass 4 Galvanized steel 6 Concrete tile 9 ABS 12 None used (open hole)
 SCREEN OR PERFORATION OPENINGS ARE:
 1 Continuous slot 3 Mill slot 7 Torch cut 11 None (open hole)
 2 Louvered shutter 4 Key punched 6 Wire wrapped 9 Drilled holes
 SCREEN-PERFORATED INTERVALS: From **8** ft. to **18** ft., From **-----** ft. to **-----** ft., From **-----** ft. to **-----** ft.
SAND GRAVEL PACK INTERVALS: From **7** ft. to **18** ft., From **-----** ft. to **-----** ft., From **-----** ft. to **-----** ft.

6 GROUT MATERIAL: 1 Neat cement 2 Cement grout 3 Bentonite 4 Other
 Grout Intervals: From **0** ft. to **5** ft., From **5** ft. to **7** ft., From **-----** ft. to **-----** ft.
 What is the nearest source of possible contamination:
 1 Septic tank 4 Lateral lines 7 Pit privy 10 Livestock pens 14 Abandoned water well
 2 Sewer lines 5 Cess pool 8 Sewage lagoon 11 Fuel storage 15 Oil well/Gas well
 3 Watertight sewer lines 6 Seepage pit 9 Feedyard 12 Fertilizer storage 16 Other (specify below) **contaminated site**
 13 Insecticide storage
 Direction from well? **How many feet?**

FROM	TO	LITHOLOGIC LOG	FROM	TO	PLUGGING INTERVALS
GL	0.50	Concrete			
0.50	1.00	Fill sand			
1.00	1.50	Fill soil			
1.50	2.00	Concrete			
2.00	18.00	Silt (ML)			
18.00	TD	End of Borehole			

D. Taylor
Flush Mount Wai
12/27/96

7 CONTRACTOR'S OR LANDOWNER'S CERTIFICATION: This water well was (1) constructed, (2) reconstructed, or (3) plugged under my jurisdiction and was completed on (mo/day/year) **4-30-97** and this record is true to the best of my knowledge and belief. Kansas Water Well Contractor's License No. **585** This Water Well Record was completed on (mo/day/yr) **5-12-97** under the business name of **NEI** by (signature) **D. Taylor**

OFFICE USE ONLY
 T
 R
 EW
 SEC.
 1/4
 1/4
 1/4