


1 LOCATION OF WATER WELL: County: **Wilson** Fraction: **NE 1/4 SW 1/4 SW 1/4** Section Number: **20** Township Number: **T 30 S** Range Number: **R 16 E/W**

Distance and direction from nearest town or city street address of well if located within city?

2 WATER WELL OWNER: RR#, St. Address, Box #: **Greaves Mini Mart Attn: Norm Castagna** Board of Agriculture, Division of Water Resources
 City, State, ZIP Code: **825 Main, Neodesha, Kansas** Application Number: -----

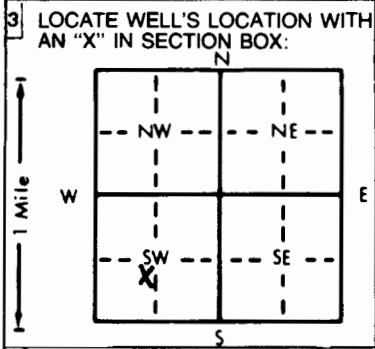

4 DEPTH OF COMPLETED WELL: **18** ft. ELEVATION: -----
 Depth(s) Groundwater Encountered 1. **12.5** ft. 2. ----- ft. 3. ----- ft.
 WELL'S STATIC WATER LEVEL **10.87** ft. below land surface measured on mo/day/yr
 Pump test data: Well water was ----- ft. after ----- hours pumping ----- gpm
 Est. Yield ----- gpm: Well water was ----- ft. after ----- hours pumping ----- gpm
 Bore Hole Diameter: **8.625** in. to **18** in. and ----- in. to ----- in. ft.
 WELL WATER TO BE USED AS: 5 Public water supply 8 Air conditioning 11 Injection well
 1 Domestic 3 Feedlot 6 Oil field water supply 9 Dewatering 12 Other (Specify below)
 2 Irrigation 4 Industrial 7 Lawn and garden only **10 Monitoring well** *mw-5*
 Was a chemical/bacteriological sample submitted to Department? Yes ----- No **X**; If yes, mo/day/yr sample was submitted -----
 Water Well Disinfected? Yes ----- No **X**

5 TYPE OF BLANK CASING USED: 1 Steel 3 RMP (SR) 5 Wrought iron 8 Concrete tile CASING JOINTS: Glued ----- Clamped -----
2 PVC 4 ABS 6 Asbestos-Cement 9 Other (specify below) Welded -----
 Blank casing diameter: **2** in. to **8** ft., Dia. ----- in. to ----- ft., Dia. ----- in. to ----- ft.
 Casing height above land surface: **0** in., weight **SCH 40 PVC** lbs./ft. Wall thickness or gauge No. -----
 TYPE OF SCREEN OR PERFORATION MATERIAL: **7** PVC 10 Asbestos-cement
 1 Steel 3 Stainless steel 5 Fiberglass 8 RMP (SR) 11 Other (specify) -----
 2 Brass 4 Galvanized steel 6 Concrete tile 9 ABS 12 None used (open hole)
 SCREEN OR PERFORATION OPENINGS ARE: 5 Gauzed wrapped 8 Saw cut 11 None (open hole)
 1 Continuous slot **3** Mill slot 6 Wire wrapped 9 Drilled holes
 2 Louvered shutter 4 Key punched 7 Torch cut 10 Other (specify) -----
 SCREEN-PERFORATED INTERVALS: From **8** ft. to **18** ft., From ----- ft. to ----- ft.
SMP
 GRAVEL PACK INTERVALS: From **7** ft. to **18** ft., From ----- ft. to ----- ft.

6 GROUT MATERIAL: 1 Neat cement 2 Cement grout 3 Bentonite 4 Other -----
 Grout Intervals: From **20** ft. to **5** ft., From **5** ft. to **7** ft., From ----- ft. to ----- ft.
 What is the nearest source of possible contamination: 10 Livestock pens 14 Abandoned water well
 1 Septic tank 4 Lateral lines 7 Pit privy 11 Fuel storage 15 Oil well/Gas well
 2 Sewer lines 5 Cess pool 8 Sewage lagoon 12 Fertilizer storage **16 Other (specify below)**
 3 Watertight sewer lines 6 Seepage pit 9 Feedyard **Contaminated site**
 13 Insecticide storage

Direction from well? How many feet?

FROM	TO	LITHOLOGIC LOG	FROM	TO	PLUGGING INTERVALS
GL	1.00	Soil, fill dirt			
1.00	13.00	Silty Clay (CL)			
13.00	18.00	Silt w/sand and gravel			
18.00	TD	Sandy Silt (ML)			

D. Taylor
Flush Mount Wai
12/27/96

7 CONTRACTOR'S OR LANDOWNER'S CERTIFICATION: This water well was (1) constructed, (2) reconstructed, or (3) plugged under my jurisdiction and was completed on (mo/day/year) **4-30-97** and this record is true to the best of my knowledge and belief. Kansas Water Well Contractor's License No. **585** This Water Well Record was completed on (mo/day/yr) **5-12-97** under the business name of **ACT** by (signature) *D. Taylor*

OFFICE USE ONLY