


1 LOCATION OF WATER WELL: Fraction NE 1/4 NE 1/4 NE 1/4 Section Number 19 Township Number T 30 S Range Number R 16 EW  
 County: Wilson

Distance and direction from nearest town or city street address of well if located within city?  
560 St South + 450 St West of Intersection of 12th Ave + Tank Ave, Neodesha, KS

2 WATER WELL OWNER: Amoco Oil Co. Board of Agriculture, Division of Water Resources  
 RR#, St. Address, Box #: 1100 N. 12th Street Application Number:  
 City, State, ZIP Code: Neodesha, KS 66757

3 LOCATE WELL'S LOCATION WITH AN "X" IN SECTION BOX: 4 DEPTH OF COMPLETED WELL: 19 ft. ELEVATION:  
 Depth(s) Groundwater Encountered 1. 16 ft. 2. ft. 3. ft.  
 WELL'S STATIC WATER LEVEL 15.54 ft. below land surface measured on mo/day/yr 9-14-01

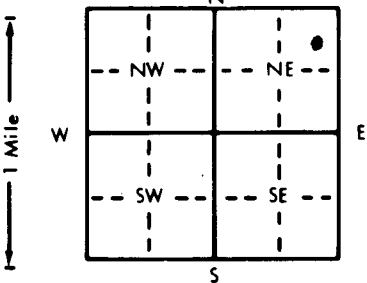

Pump test data: Well water was N/A ft. after hours pumping gpm  
 Est. Yield N/A gpm Well water was ft. after hours pumping gpm  
 Bore Hole Diameter 8 in. to 19 ft. and in. to ft.  
 WELL WATER TO BE USED AS:  
 1 Domestic 3 Feedlot 6 Oil field water supply 9 Dewatering 12 Other (Specify below)  
 2 Irrigation 4 Industrial 7 Lawn and garden only  10 Monitoring well  
 Was a chemical/bacteriological sample submitted to Department? Yes  No  If yes, mo/day/yr sample was submitted  
 Water Well Disinfected? Yes  No

5 TYPE OF BLANK CASING USED: 5 Wrought iron 8 Concrete tile CASING JOINTS: Glued Clamped  
 1 Steel 3 RMP (SR) 6 Asbestos-Cement 9 Other (specify below) Welded  
 2 PVC 4 ABS 7 Fiberglass  Threaded

Blank casing diameter 2 in. to 9 ft., Dia. in. to ft., Dia. in. to ft.  
 Casing height above land surface 0 in., weight 6.82 lbs./ft. Wall thickness or gauge No. 15.4"

TYPE OF SCREEN OR PERFORATION MATERIAL:  7 PVC 10 Asbestos-cement  
 1 Steel 3 Stainless steel 5 Fiberglass 8 RMP (SR) 11 Other (specify)  
 2 Brass 4 Galvanized steel 6 Concrete tile 9 ABS 12 None used (open hole)

SCREEN OR PERFORATION OPENINGS ARE:  
 1 Continuous slot  3 Mill slot 5 Gauzed wrapped 8 Saw cut 11 None (open hole)  
 2 Louvered shutter 4 Key punched 6 Wire wrapped 9 Drilled holes  
 7 Torch cut 10 Other (specify)

SCREEN-PERFORATED INTERVALS: From 9 ft. to 19 ft. From ft. to ft.  
 From ft. to ft. From ft. to ft.  
 GRAVEL PACK INTERVALS: From 7 ft. to 19 ft. From ft. to ft.  
 From ft. to ft. From ft. to ft.

6 GROUT MATERIAL: 1 Neat cement 2 Cement grout  3 Bentonite 4 Other  
 Grout Intervals: From 0 ft. to 7 ft. From ft. to ft. From ft. to ft.

What is the nearest source of possible contamination:  
 1 Septic tank 4 Lateral lines 7 Pit privy  11 Fuel storage 14 Abandoned water well  
 2 Sewer lines 5 Cess pool 8 Sewage lagoon 12 Fertilizer storage 15 Oil well/Gas well  
 3 Watertight sewer lines 6 Seepage pit 9 Feedyard 13 Insecticide storage 16 Other (specify below)  
 Direction from well? North How many feet? 600

FROM	TO	LITHOLOGIC LOG	FROM	TO	PLUGGING INTERVALS
0	3	Drk Brn Silt			
3	5	Brn Silt			
5	12 1/2	Blue-Gray w/ yellow-Brn mottling clay			
12 1/2	17 1/2	Gray fine grained Sandy Clay			
17 1/2	19	Gray Gravel w/ Clay			

7 CONTRACTOR'S OR LANDOWNER'S CERTIFICATION: This water well was  (1) constructed (2) reconstructed, or (3) plugged under my jurisdiction and was completed on (mo/day/year) 7/25/01 and this record is true to the best of my knowledge and belief. Kansas Water Well Contractor's License No. 616 This Water Well Record was completed on (mo/day/yr) 8/24/01 under the business name of Thiele Geotech, Inc by (signature) D-JAL

OFFICE USE ONLY  
T  
R  
EW  
SEC.