


1 LOCATION OF WATER WELL: Fraction **NE ¼ NE ¼ NE ¼** Section Number **19** Township Number **T 30 S** Range Number **R 16** E/W

County: **Wilson**
 Distance and direction from nearest town or city street address of well if located within city? MW-90
180ft South & 305 West of Intersection of 12th Ave. & Tank Ave, Neodesha, Ks

2 WATER WELL OWNER: **BP Amoco Oil Co.**
 RR#, St. Address, Box # : **1100 North 12th Street**
 City, State, ZIP Code : **Neodesha, Kansas 66757**
 Board of Agriculture, Division of Water Resources
 Application Number: **Not Applicable**

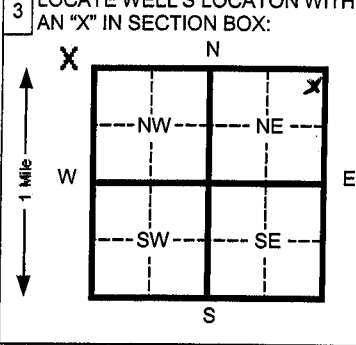

4 DEPTH OF COMPLETED WELL **18** ft. ELEVATION: _____
 Depth(s) Groundwater Encountered 1 **15** ft. 2 _____ ft. 3 _____ ft.
 WELL'S STATIC WATER LEVEL _____ ft. below land surface measured on mo/day/yr
 Pump test data: Well water was _____ ft. after _____ hours pumping _____ gpm
 Est. Yield _____ gpm: Well water was _____ ft. after _____ hours pumping _____ gpm
 Bore Hole Diameter **8** in. to **18** ft. and _____ in. to _____ ft.
 WELL WATER TO BE USED AS:
 1 Domestic 2 Irrigation 3 Feed lot 4 Industrial 5 Public water supply 6 Oil field water supply 7 Lawn and garden (domestic) 8 Air conditioning 9 Dewatering 10 **Monitoring well** 11 Injection well 12 Other (Specify below)
 Was a chemical/bacteriological sample submitted to Department? Yes _____ No **X** If yes, mo/day/yr sample was submitted _____
 Water Well Disinfected? Yes _____ No _____

5 TYPE OF BLANK CASING USED:
 1 Steel 2 **PVC** 3 RMP (SR) 4 ABS 5 Wrought Iron 6 Asbestos-Cement 7 Fiberglass 8 Concrete tile 9 Other (specify below)
 Blank casing diameter **2.00** in. to **8** ft., Dia _____ in. to _____ ft., Dia _____ in. to _____ ft.
 Casing height above land surface **0.00** in., weight **N/A** lbs./ft. Wall thickness or gauge No. **.1875**
 TYPE OF SCREEN OR PERFORATION MATERIAL:
 1 Steel 2 Brass 3 Stainless steel 4 Galvanized steel 5 Fiberglass 6 Concrete tile 7 **PVC** 8 RMP (SR) 9 ABS 10 Asbestos-cement 11 Other (specify) 12 None used (open hole)
 SCREEN OR PERFORATION OPENINGS ARE:
 1 Continuous slot 2 Louvered shutter 3 **Mill slot** 4 Key punched 5 Gauzed wrapped 6 Wire wrapped 7 Torch cut 8 Saw cut 9 Drilled holes 11 None (open hole)
 SCREEN-PERFORATED INTERVALS: From **8** ft. to **18** ft. From _____ ft. to _____ ft. From _____ ft. to _____ ft.
 GRAVEL PACK INTERVALS: From **6** ft. to **18** ft. From _____ ft. to _____ ft. From _____ ft. to _____ ft.

6 GROUT MATERIAL: 1 Neat cement 2 Cement grout 3 **Bentonite** 4 Other _____
 Grout intervals From **0.5** ft. to **6** ft. From _____ ft. to _____ ft. From _____ ft. to _____ ft.
 What is the nearest source of possible contamination:
 1 Septic tank 2 Sewer lines 3 Watertight sewer lines 4 Lateral lines 5 Cess pool 6 Seepage pit 7 Pit privy 8 Sewage lagoon 9 Feedyard 10 Livestock pens 11 **Fuel storage** 12 Fertilizer storage 13 Insecticide storage 14 Abandoned water well 15 Oil well/ Gas well 16 Other (specify below)
 Direction from well? **North** How many feet? **200**

FROM	TO	CODE	LITHOLOGIC LOG	FROM	TO	PLUGGING INTERVALS
0	5	01	CLAY FILL			
5	10	01	CLAY, MOTTLED GR/YELLOW			
10	15	03	SILTY CLAY			
15	16	03	SILTY CLAY W/ SAND			
16	18	13	GRAVEL W/ SANDS AND CLAYS			
18		23	BEDROCK- SANDSTONE			

7 CONTRACTOR'S OR LANDOWNER'S CERTIFICATION: This water well was **(1)** constructed, (2) reconstructed, or (3) plugged under my jurisdiction and was completed on (mo/day/yr) **07-09-02** and this record is true to the best of my knowledge and belief. Kansas
 Water Well Contractor's License No. **606** This Water Well Record was completed on (mo/day/yr) **07-25-02**
 under the business name of **Thiele Geotech, Inc.** by (signature) *D. J. [Signature]*

OFFICE USE ONLY

T

R

SEC