


1 LOCATION OF WATER WELL: County: Wilson	Fraction NW ¼ SE ¼ NE ¼	Section Number 19	Township Number T 30 S	Range Number R 16 EW
--	-----------------------------------	-----------------------------	----------------------------------	--------------------------------

Distance and direction from nearest town or city street address of well if located within city? **MW-132**
The well is located approximately 2,030 feet south and 970 feet west of the intersection of N. 11th St. and Tank Avenue in Neodesha. Latitude N37° 25.382' Longitude W95° 41.467'

2 WATER WELL OWNER: BP Amoco Oil Co. RR#, St. Address, Box # : 1100 North 12th Street City, State, ZIP Code : Neodesha, Kansas 66757	Board of Agriculture, Division of Water Resources Application Number: Not Applicable
--	--

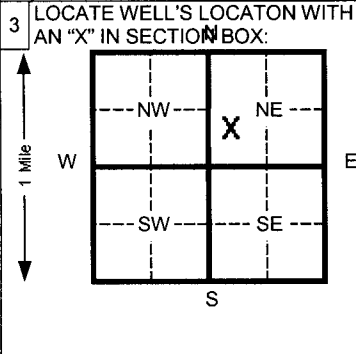

4 DEPTH OF COMPLETED WELL 13 ft. ELEVATION: _____	Depth(s) Groundwater Encountered 1 4 ft. 2 _____ ft. 3 _____ ft.
WELL'S STATIC WATER LEVEL Unk. ft. below land surface measured on mo/day/yr	
Pump test data: Well water was _____ ft. after _____ hours pumping _____ gpm	
Est. Yield _____ gpm: Well water was _____ ft. after _____ hours pumping _____ gpm	
Bore Hole Diameter 8 in. to 13 ft. and _____ in. to _____ ft.	
WELL WATER TO BE USED AS: 5 Public water supply 8 Air conditioning 11 Injection well	
1 Domestic 3 Feed lot 6 Oil field water supply 9 Dewatering 12 Other (Specify below)	
2 Irrigation 4 Industrial 7 Lawn and garden (domestic) 10 Monitoring well	
Was a chemical/bacteriological sample submitted to Department? Yes _____ No X If yes, mo/day/yr sample was submitted _____	
Water Well Disinfected? Yes _____ No _____	

5 TYPE OF BLANK CASING USED:	5 Wrought Iron 8 Concrete tile CASING JOINTS: Glued _____ Clamped _____	Welded _____
1 Steel 3 RMP (SR)	6 Asbestos-Cement 9 Other (specify below) _____	Threaded
2 PVC 4 ABS	7 Fiberglass _____	
Blank casing diameter 2 in. to 3.5 ft., Dia _____ in. to _____ ft., Dia _____ in. to _____ ft.	Casing height above land surface 0 in., weight N/A lbs./ft. Wall thickness or gauge No. 0.1875	
TYPE OF SCREEN OR PERFORATION MATERIAL: 7 PVC 10 Asbestos-cement		
1 Steel 3 Stainless steel 5 Fiberglass 8 RMP (SR) 11 Other (specify) _____	2 Brass 4 Galvanized steel 6 Concrete tile 9 ABS 12 None used (open hole)	
SCREEN OR PERFORATION OPENINGS ARE: 5 Gauzed wrapped 8 Saw cut 11 None (open hole)		
1 Continuous slot 3 Mill slot 6 Wire wrapped 9 Drilled holes	2 Louvered shutter 4 Key punched 7 Torch cut 10 Other (specify) _____	
SCREEN-PERFORATED INTERVALS: From 3.5 ft. to 13 ft. From _____ ft. to _____ ft.		
GRAVEL PACK INTERVALS: From 3 ft. to 13 ft. From _____ ft. to _____ ft.		

6 GROUT MATERIAL: 1 Neat cement 2 Cement grout 3 Bentonite 4 Other _____	Grout Intervals From 0.5 ft. to 3 ft. From _____ ft. to _____ ft. From _____ ft. to _____ ft.
What is the nearest source of possible contamination:	
1 Septic tank 4 Lateral lines 7 Pit privy 11 Fuel storage 15 Oil well/ Gas well	10 Livestock pens 14 Abandoned water well
2 Sewer lines 5 Cess pool 8 Sewage lagoon 12 Fertilizer storage 16 Other (specify below)	3 Watertight sewer lines 6 Seepage pit 9 Feedyard 13 Insecticide storage
Direction from well? North How many feet? 1,000	

FROM	TO	CODE	LITHOLOGIC LOG	FROM	TO	PLUGGING INTERVALS
0	3	02	Silt			
3	5	03	Silty Clay			
5	10	05	Clayey Sand			
10	12.8	11	Clayey Sandy Gravel			
12.8	13	28	Bedrock			

7 CONTRACTOR'S OR LANDOWNER'S CERTIFICATION: This water well was (1) constructed , (2) reconstructed, or (3) plugged under my jurisdiction and was completed on (mo/day/yr) 8/27/03 and this record is true to the best of my knowledge and belief. Kansas Water Well Contractor's License No. 616 This Water Well Record was completed on (mo/day/yr) 11/19/03 under the business name of Thiele Geotech, Inc. by (signature) <i>D. J. A. C.</i>
--

INSTRUCTIONS: Please fill in blanks and circle the correct answers. Send three copies to Kansas Department of Health and Environment, Bureau of Water, Topeka, Kansas 66620-0001. Telephone: 913-296-5545. Send one to WATER WELL OWNER and retain one for your records.