


|  |                                   |                             |                                  |                                 |
|--|-----------------------------------|-----------------------------|----------------------------------|---------------------------------|
| 1 LOCATION OF WATER WELL:<br>County: <b>Wilson</b> | Fraction<br><b>SE ¼ NW ¼ NW ¼</b> | Section Number<br><b>20</b> | Township Number<br><b>T 30 S</b> | Range Number<br><b>R 16 E/W</b> |
|--|-----------------------------------|-----------------------------|----------------------------------|---------------------------------|

Distance and direction from nearest town or city street address of well if located within city? **SAW-5**  
**The well is located approximately 150 feet east of N. 9<sup>th</sup> St. within the alley between Carolina and Grant Streets in Neodesha.**  
**Latitude N37° 25.511' Longitude W95° 41.054'**

2 WATER WELL OWNER: **BP Amoco Oil Co.**  
 RR#, St. Address, Box # : **1100 North 12<sup>th</sup> Street**  
 City, State, ZIP Code : **Neodesha, Kansas 66757**  
 Board of Agriculture, Division of Water Resources  
 Application Number: **Not Applicable**

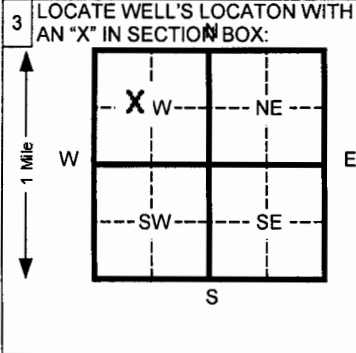

4 DEPTH OF COMPLETED WELL **22** ft. ELEVATION: \_\_\_\_\_  
 Depth(s) Groundwater Encountered 1 **20** ft. 2 \_\_\_\_\_ ft. 3 \_\_\_\_\_ ft.  
 WELL'S STATIC WATER LEVEL **Unk.** ft. below land surface measured on mo/day/yr  
 Pump test data: Well water was \_\_\_\_\_ ft. after \_\_\_\_\_ hours pumping \_\_\_\_\_ gpm  
 Est. Yield \_\_\_\_\_ gpm: Well water was \_\_\_\_\_ ft. after \_\_\_\_\_ hours pumping \_\_\_\_\_ gpm  
 Bore Hole Diameter **14.75** in. to **22.5** ft. and \_\_\_\_\_ in. to \_\_\_\_\_ ft.  
 WELL WATER TO BE USED AS: 5 Public water supply 8 Air conditioning 11 Injection well  
 1 Domestic 3 Feed lot 6 Oil field water supply 9 Dewatering 12 Other (Specify below)  
 2 Irrigation 4 Industrial 7 Lawn and garden (domestic) **10** Monitoring well  
 Was a chemical/bacteriological sample submitted to Department? Yes \_\_\_\_\_ No **X** If yes, mo/day/yr sample was submitted  
 Water Well Disinfected? Yes \_\_\_\_\_ No \_\_\_\_\_

5 TYPE OF BLANK CASING USED:  
 1 Steel 3 RMP (SR) 5 Wrought Iron 8 Concrete tile CASING JOINTS: Glued \_\_\_\_\_ Clamped \_\_\_\_\_  
**2** PVC 4 ABS 6 Asbestos-Cement 9 Other (specify below) \_\_\_\_\_ Welded \_\_\_\_\_  
 7 Fiberglass \_\_\_\_\_ Threaded \_\_\_\_\_  
 Blank casing diameter **4** in. to **7** ft., Dia \_\_\_\_\_ in. to \_\_\_\_\_ ft., Dia \_\_\_\_\_ in. to \_\_\_\_\_ ft.  
 Casing height above land surface **0** in., weight **N/A** lbs./ft. Wall thickness or gauge No. **0.2370**  
 TYPE OF SCREEN OR PERFORATION MATERIAL:  
 1 Steel 3 Stainless steel 5 Fiberglass 8 RMP (SR) 10 Asbestos-cement  
 2 Brass 4 Galvanized steel 6 Concrete tile 9 ABS 11 Other (specify) \_\_\_\_\_  
 12 None used (open hole) \_\_\_\_\_  
 SCREEN OR PERFORATION OPENINGS ARE:  
 5 Gauzed wrapped 8 Saw cut 11 None (open hole)  
 1 Continuous slot 3 Mill slot **6** Wire wrapped 9 Drilled holes  
 2 Louvered shutter 4 Key punched 7 Torch cut 10 Other (specify) \_\_\_\_\_  
 SCREEN-PERFORATED INTERVALS: From **7** ft. to **22** ft. From \_\_\_\_\_ ft. to \_\_\_\_\_ ft.  
 GRAVEL PACK INTERVALS: From **5** ft. to **22.5** ft. From \_\_\_\_\_ ft. to \_\_\_\_\_ ft.  
 From \_\_\_\_\_ ft. to \_\_\_\_\_ ft. From \_\_\_\_\_ ft. to \_\_\_\_\_ ft.

6 GROUT MATERIAL: 1 Neat cement 2 Cement grout **3 Bentonite** 4 Other \_\_\_\_\_  
 Grout Intervals From **2.5** ft. to **5** ft. From \_\_\_\_\_ ft. to \_\_\_\_\_ ft. From \_\_\_\_\_ ft. to \_\_\_\_\_ ft.  
 What is the nearest source of possible contamination:  
 1 Septic tank 4 Lateral lines 7 Pit privy **11** Fuel storage 14 Abandoned water well  
 2 Sewer lines 5 Cess pool 8 Sewage lagoon 12 Fertilizer storage 15 Oil well/ Gas well  
 3 Watertight sewer lines 6 Seepage pit 9 Feedyard 13 Insecticide storage 16 Other (specify below) \_\_\_\_\_  
 Direction from well? **Northwest** How many feet? **1,650**

| FROM | TO   | CODE | LITHOLOGIC LOG                            | FROM | TO | PLUGGING INTERVALS |
|------|------|------|---|------|----|--------------------|
| 0    | 1    | 02   | Fill gravel                               |      |    |                    |
| 1    | 10   | 03   | Tan, sandy, silty clay                    |      |    |                    |
| 10   | 16   | 05   | Tan to gray, clayey, fine grained sand    |      |    |                    |
| 16   | 22.5 | 11   | Gray, clayey, sandy gravel, poorly sorted |      |    |                    |
|      | 22.5 | 28   | Bedrock                                   |      |    |                    |


**RECEIVED**  
**NOV 08 2004**  
**BUREAU OF WATER**

7 CONTRACTOR'S OR LANDOWNER'S CERTIFICATION: This water well was (1) constructed, (2) reconstructed, or (3) plugged under my jurisdiction and was completed on (mo/day/yr) **9/9/04** and this record is true to the best of my knowledge and belief, Kansas Water Well Contractor's License No. **616** This Water Well Record was completed on (mo/day/yr) **11/4/04** under the business name of **Thiele Geotech, Inc.** by (signature) *D. J. ...*

INSTRUCTIONS: Please fill in blanks and circle the correct answers. Send three copies to Kansas Department of Health and Environment, Bureau of Water, Topeka, Kansas 66620-0001. Telephone: 913-296-5545. Send one to WATER WELL OWNER and retain one for your records.



# NEODESHA

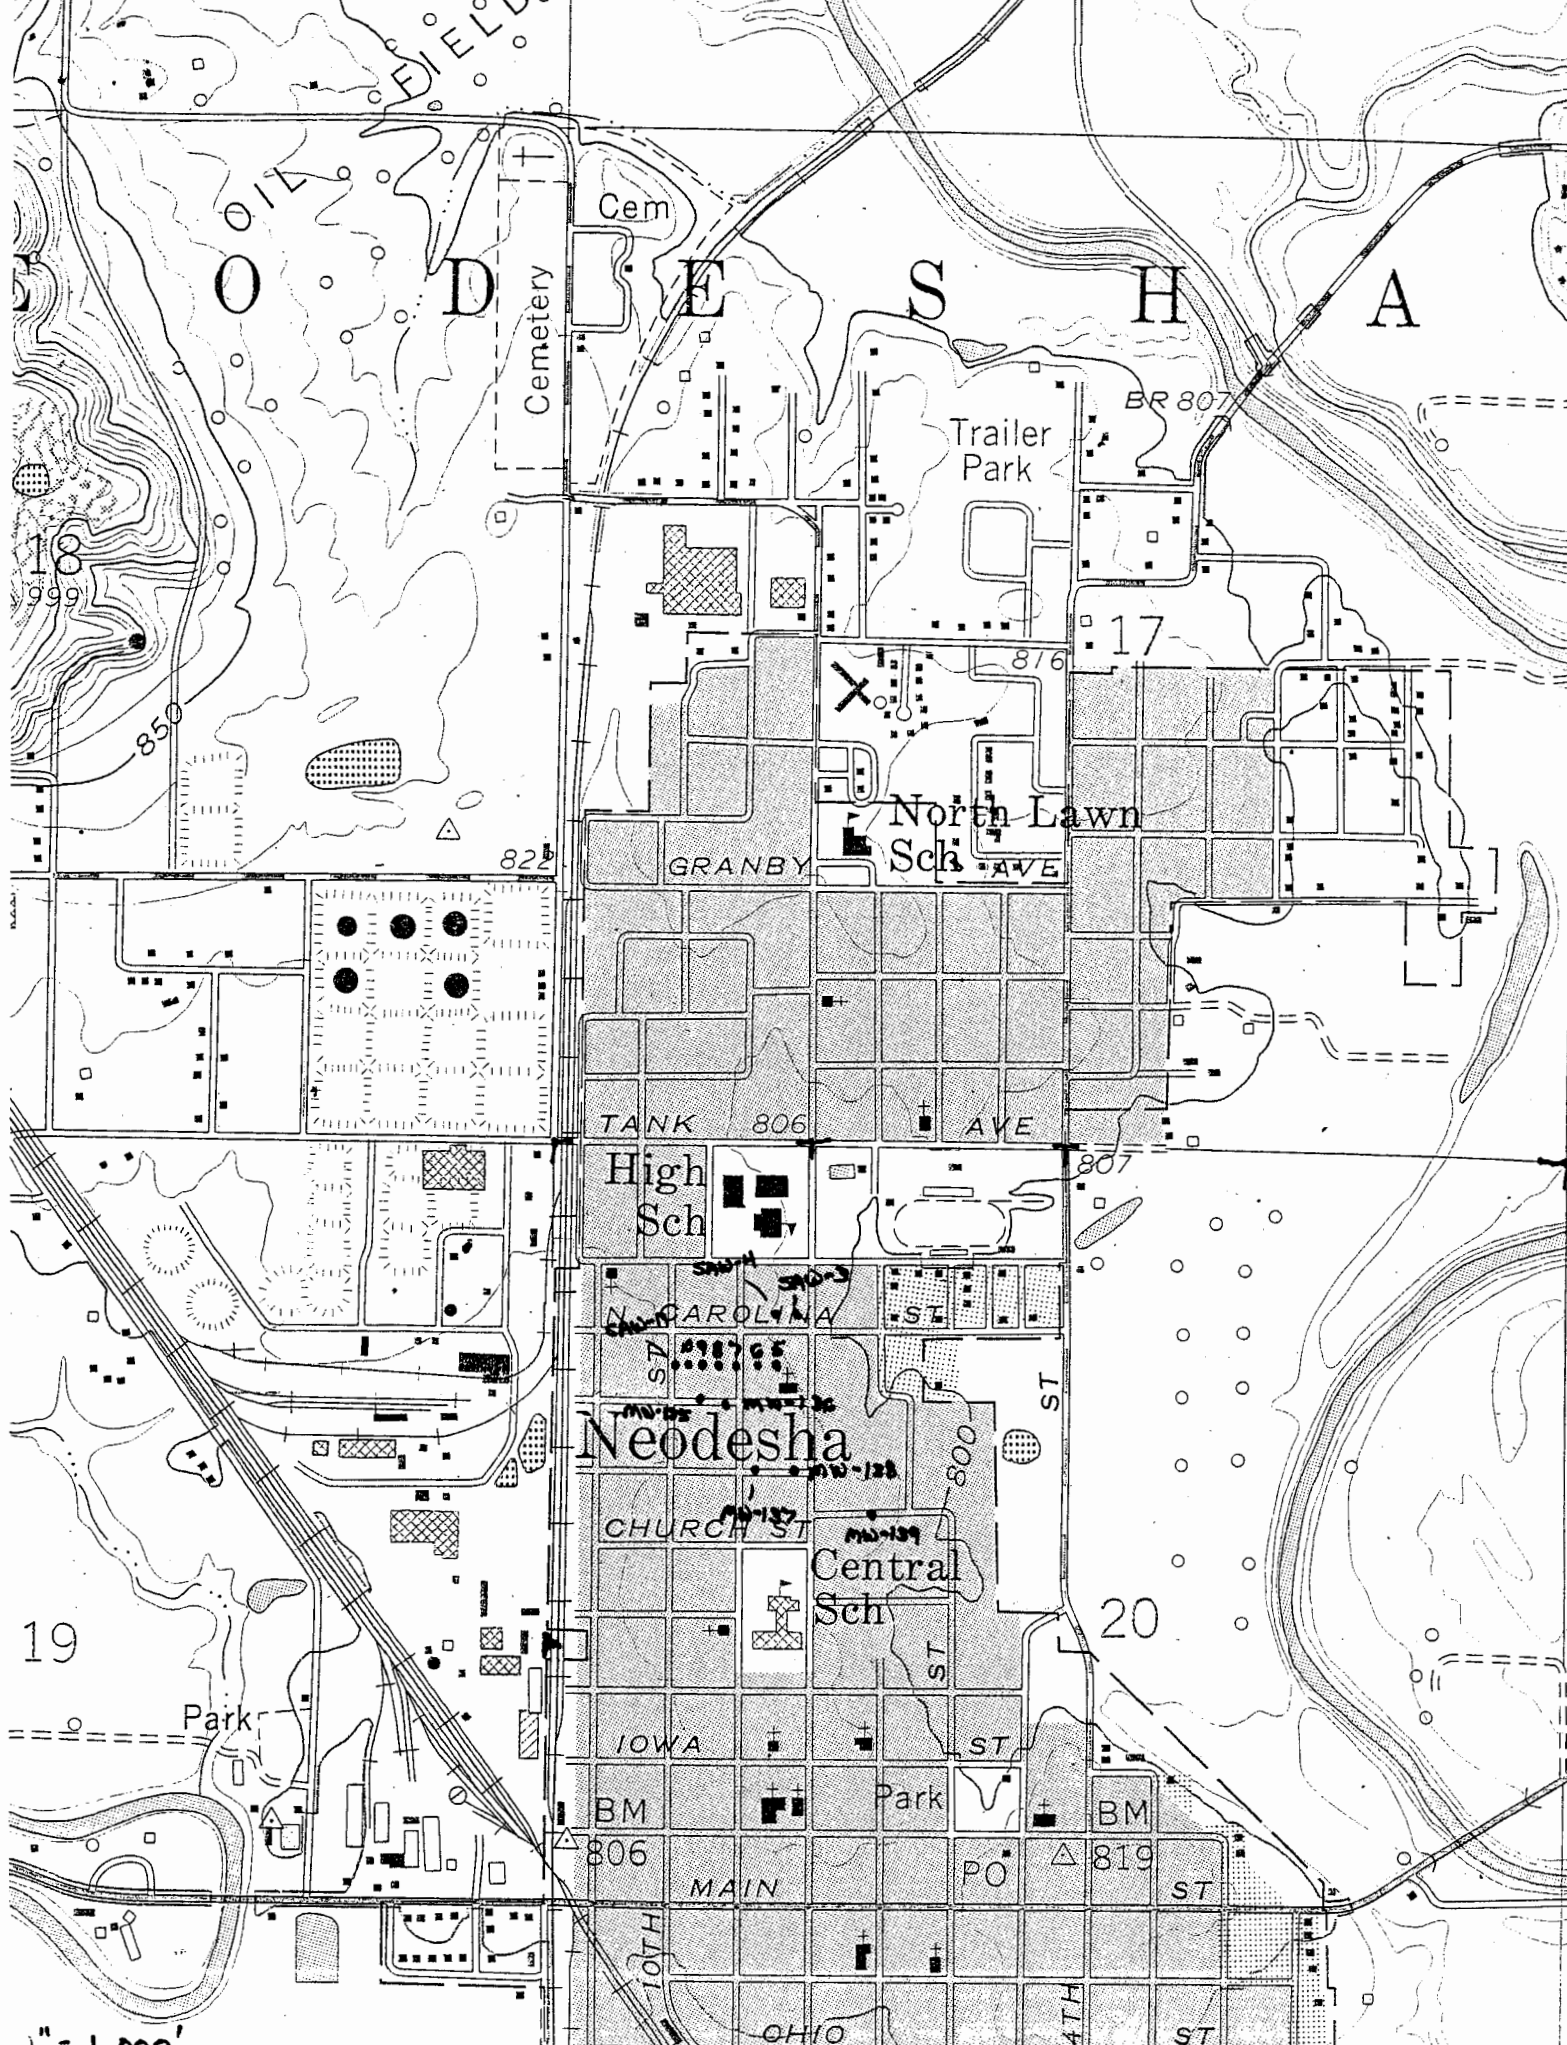

1" = 1,000'