


1 LOCATION OF WATER WELL: Fraction	Section Number	Township Number	Range Number
County: <b>Wilson</b> SE 1/4 NW 1/4 NW 1/4	<b>20</b>	<b>30S</b>	<b>16E</b>

Distance and direction from nearest town or city street address of well if located within city?

See map

2 WATER WELL OWNER: **BP Amoco Oil Co.**  
 RR#, St. Address, Box # **1100 North 12<sup>th</sup> Street** Board of Agriculture, Division of Water Resources  
 City, State, ZIP Code : **Neodesha, Kansas 66757** Application Number: Not Applicable

3 MARK WELL'S LOCATON WITH AN "X" IN SECTION BOX:

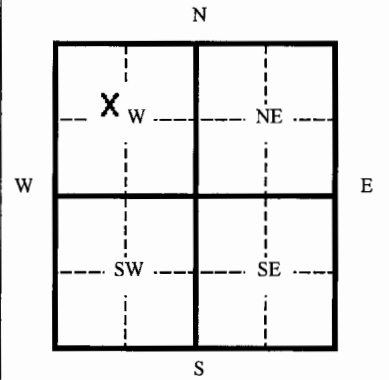

4 DEPTH OF WELL **26.5** ft.  
 WELL'S STATIC WATER LEVEL **Unk.** ft.  
 WELL WAS USED AS:  
 1 Domestic 5 Public Water Supply 9 Dewatering  
 2 Irrigation 6 Oil Field Water Supply 10 Monitoring Well  
 3 Feedlot 7 Lawn and Garden (domestic) 11 Injection Well  
 4 Industrial 8 Air Conditioning 12 Other \_\_\_\_\_  
 Was a chemical/bacteriological sample submitted to Department? Yes \_\_\_ No **X**  
 If yes, mo/day/yr sample was submitted \_\_\_\_\_  
 Water Well Disinfected: Yes \_\_\_ No **X**

5 TYPE OF BLANK CASING USED:  
 1 Steel 3 RMP (SR) 5 Wrought 7 Fiberglass 9 Other (specify below)  
 2 PVC 4 ABC 6 Asbestos-Cement 8 Concrete Tile  
 Blank casing diameter **6** in. Was casing pulled? Yes **X** No \_\_\_ If yes, how much **26.5** ft.  
 Casing height above or below land surface **0** in.

6 GROUT PLUG MATERIAL: 1 Neat cement 2 Cement grout 3 Bentonite 4 Other \_\_\_\_\_  
 Grout Plug Intervals From **0** ft. to **26.5** ft. From \_\_\_\_\_ ft. to \_\_\_\_\_ ft. From \_\_\_\_\_ ft. to \_\_\_\_\_ ft.  
 What is the nearest source of possible contamination:  
 1 Septic tank 6 Seepage pit 11 Fuel storage 16 Other (specify below)  
 2 Sewer lines 7 Pit privy 12 Fertilizer storage  
 3 Watertight sewer lines 8 Sewage lagoon 13 Insecticide storage  
 4 Lateral lines 9 Feedyard 14 Abandoned water well  
 5 Cess Pool 10 Livestock pens 15 Oil well/ Gas well

Direction from well? **Northwest** How many feet? **1,500**

FROM	TO	CODE	PLUGGING MATERIALS
0	26.5	-	bentonite

7 CONTRACTOR'S OR LANDOWNER'S CERTIFICATION: This water well was plugged under my jurisdiction and was completed on (mo/day/yr) **11/30/05** and this record is true to the best of my knowledge and belief. Kansas Water Well Contractor's License No. **616** This Water Well Record was completed on (mo/day/yr) **3/7/06** under the business name of **Thiele Geotech, Inc.**  
 by (signature) *D. J. A. K.*

INSTRUCTIONS: Please fill in blanks and circle the correct answers. Send three copies to Kansas Department of Health and Environment, Bureau of Water, 1000 S W Jackson St., Ste. 420, Topeka, Kansas 66620-0001. Telephone: 785-296-3565. Send one to Water Well Owner and retain one for your records.

F-369



T-818 P.002

9133621044

From: Retec KC

14:25

11-12-02

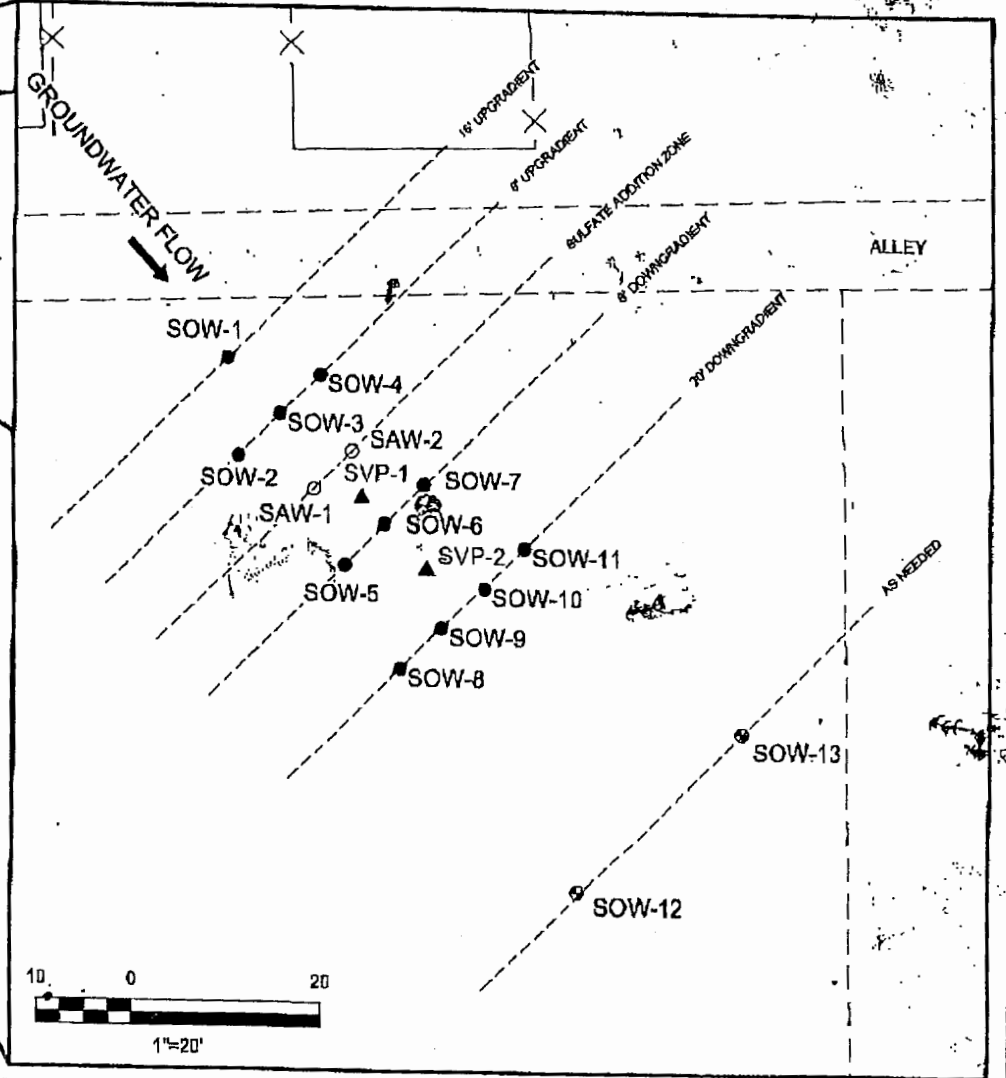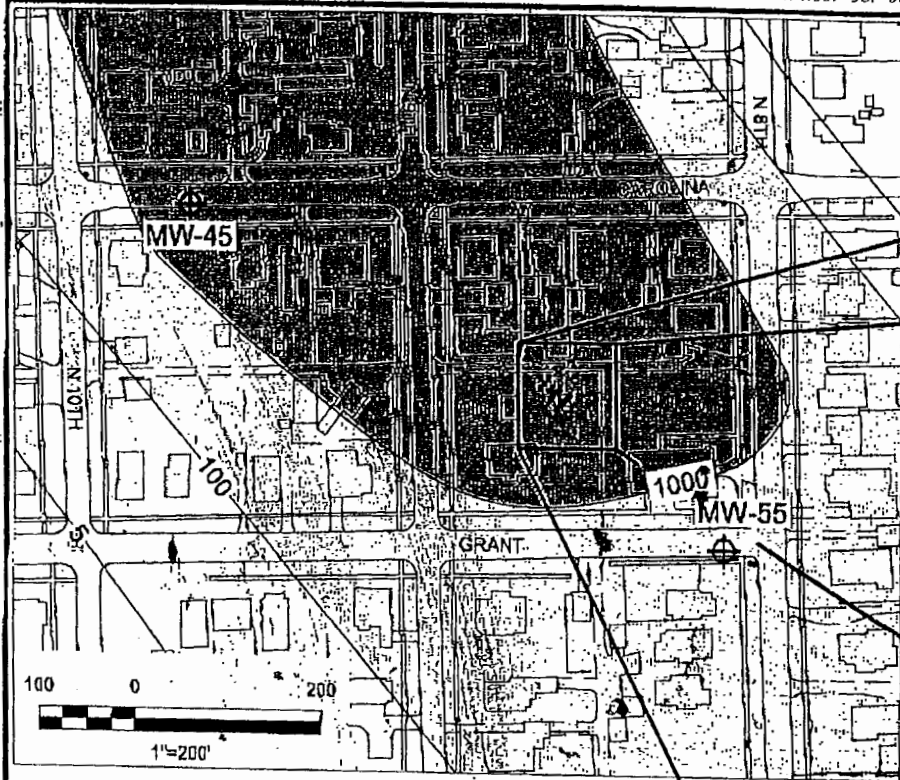

**LEGEND**

- SAW-1 ○ Sulfate Addition Well
- SOW-5 ● Sulfate Monitoring Well
- SVP-2 ▲ Soil Vapor Monitoring Point (Hydrogen Sulfide)
- SOW-12 ○ Optional SOW
- 1000 [shaded box] Benzene Concentration in Groundwater Contour (ug/l) (Contour Interval Not Equal) (10/01)

NOTE: UPGRADIENT AND DOWNGRADIENT WELL LOCATIONS ARE RELATIVE TO THE SULFATE ADDITION ZONE




Pilot Study Work Plan for Enhancing the Biodegradation of Benzene through Sulfate Addition to Groundwater  
 Amoco Oil Company, Neodesha, KS (AM061-15705-612)

**CONCEPTUAL PILOT SYSTEM LAYOUT**

DATE: 10/03/02 DRWN: E.S.S.

**FIGURE A-1**

1. S. P. ...

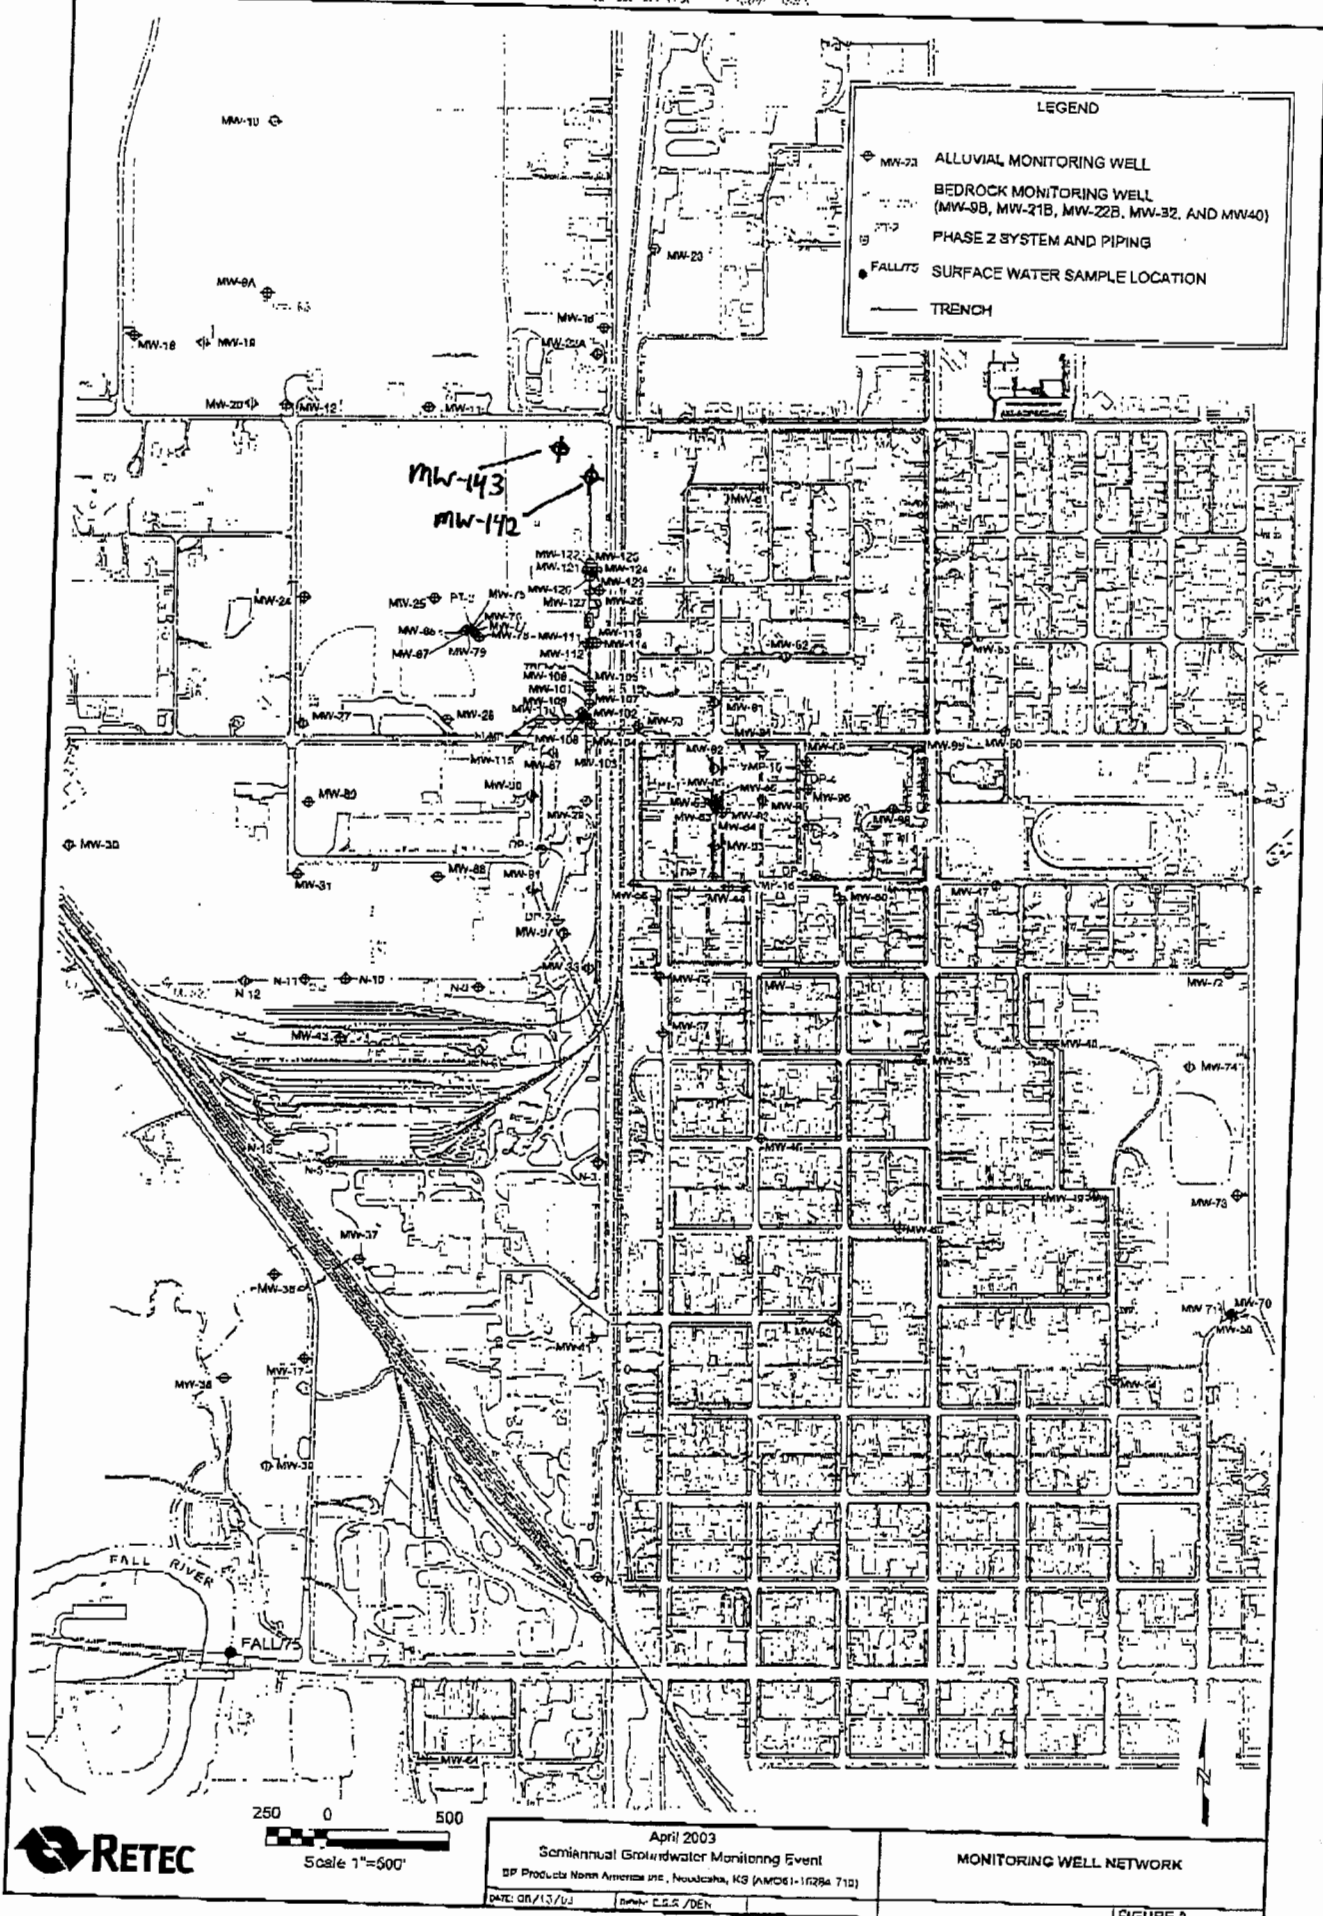

250 0 500  
Scale 1"=500'

April 2003  
Semiannual Groundwater Monitoring Event  
SP Products North America Inc., Nouiscaha, KS (AM061-10284 710)  
DATE: 08/13/03 BY: C.S.S./DEN

MONITORING WELL NETWORK

FIGURE 2