


1 LOCATION OF WATER WELL: Fraction	Section Number	Township Number	Range Number
County: Wilson SE ¼ NW ¼ NW ¼	20	30S	16E

Distance and direction from nearest town or city street address of well if located within city?

See map

2 WATER WELL OWNER: **BP Amoco Oil Co.**
 RR#, St. Address, Box # **1100 North 12th Street** Board of Agriculture, Division of Water Resources
 City, State, ZIP Code : **Neodesha, Kansas 66757** Application Number: **Not Applicable**

3 MARK WELL'S LOCATON WITH AN "X" IN SECTION BOX:

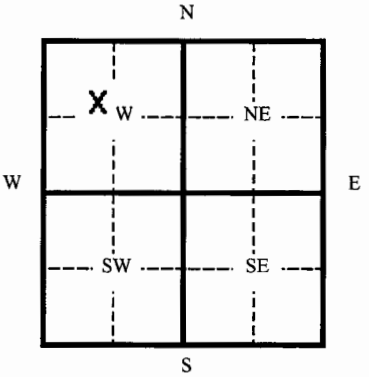

4 DEPTH OF WELL **28** ft.

WELL'S STATIC WATER LEVEL **Unk.** ft.

WELL WAS USED AS:

- 1 Domestic
- 2 Irrigation
- 3 Feedlot
- 4 Industrial
- 5 Public Water Supply
- 6 Oil Field Water Supply
- 7 Lawn and Garden (domestic)
- 8 Air Conditioning
- 9 Dewatering
- 10 Monitoring Well
- 11 Injection Well
- 12 Other

Was a chemical/bacteriological sample submitted to Department? Yes ___ No

If yes, mo/day/yr sample was submitted _____

Water Well Disinfected: Yes ___ No

5 TYPE OF BLANK CASING USED:

- 1 Steel
- 2 PVC
- 3 RMP (SR)
- 4 ABC
- 5 Wrought
- 6 Asbestos-Cement
- 7 Fiberglass
- 8 Concrete Tile
- 9 Other (specify below)

Blank casing diameter **2** in. Was casing pulled? Yes No ___ If yes, how much **28** ft.

Casing height above or below land surface **0** in.

6 GROUT PLUG MATERIAL: 1 Neat cement 2 Cement grout 3 Bentonite 4 Other

Grout Plug Intervals From **0** ft. to **28** ft. From ___ ft. to ___ ft. From ___ ft. to ___ ft.

What is the nearest source of possible contamination:

- 1 Septic tank
- 2 Sewer lines
- 3 Watertight sewer lines
- 4 Lateral lines
- 5 Cess Pool
- 6 Seepage pit
- 7 Pit privy
- 8 Sewage lagoon
- 9 Feedyard
- 10 Livestock pens
- 11 Fuel storage
- 12 Fertilizer storage
- 13 Insecticide storage
- 14 Abandoned water well
- 15 Oil well/ Gas well
- 16 Other (specify below)

Direction from well? **Northwest**

How many feet? **1,500**

FROM	TO	CODE	PLUGGING MATERIALS
0	28	-	bentonite

7 CONTRACTOR'S OR LANDOWNER'S CERTIFICATION: This water well was plugged under my jurisdiction and was completed on (mo/day/yr) **11/30/05** and this record is true to the best of my knowledge and belief. Kansas Water Well Contractor's License No. **616** This Water Well Record was completed on (mo/day/yr) **3/7/06** under the business name of **Thiele Geotech, Inc.** by (signature) *D. J. A. E.*

INSTRUCTIONS: Please fill in blanks and circle the correct answers. Send three copies to Kansas Department of Health and Environment, Bureau of Water, 1000 S W Jackson St., Ste. 420, Topeka, Kansas 66620-0001. Telephone: 785-296-3565. Send one to Water Well Owner and retain one for your records.

F-369



T-818 P.002

9133621044

From: Retec KC

14:25

11-12-02

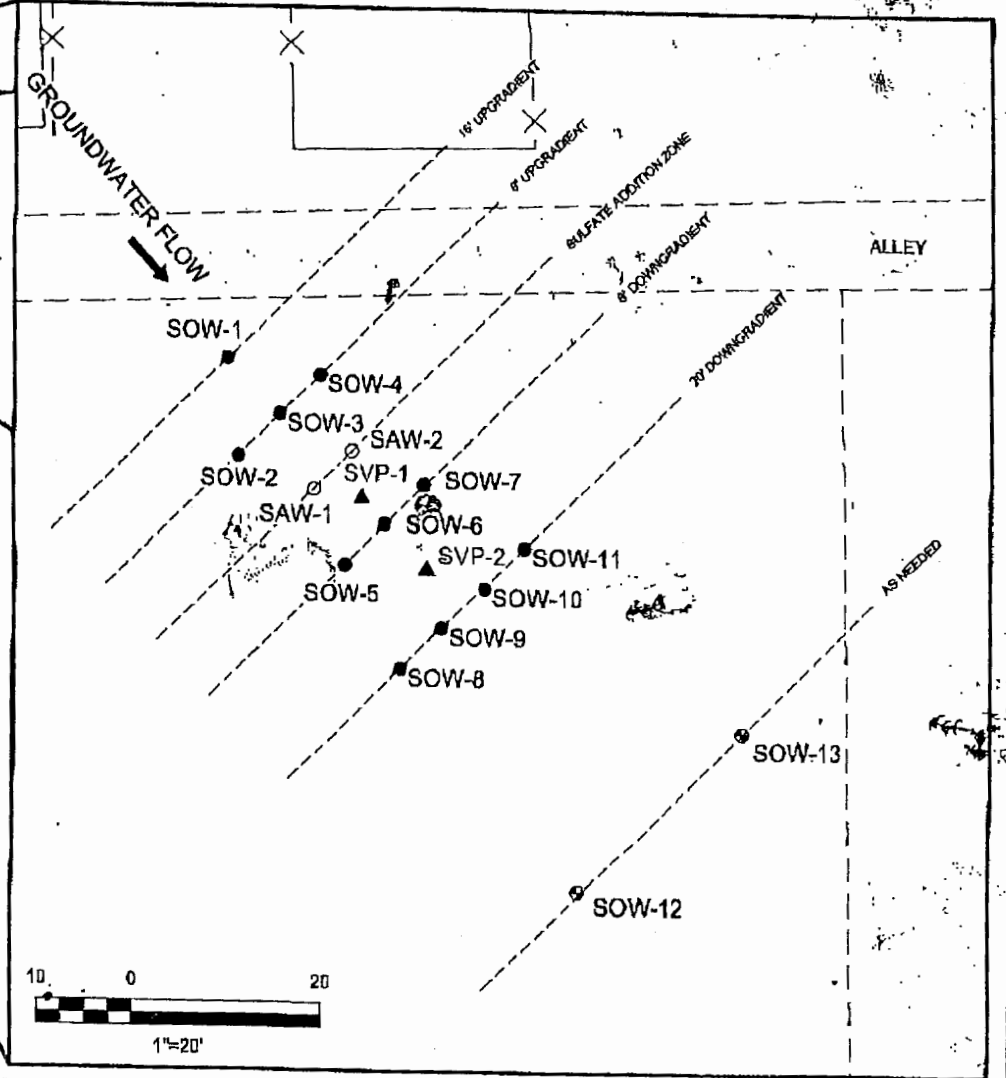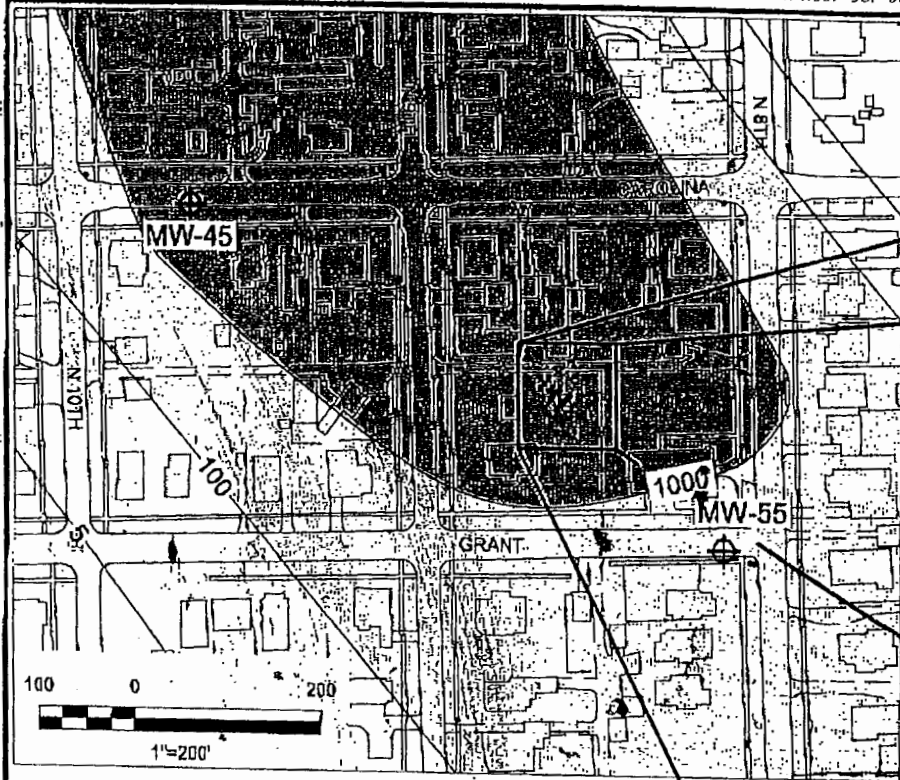

LEGEND

- SAW-1 ○ Sulfate Addition Well
- SOW-5 ● Sulfate Monitoring Well
- SVP-2 ▲ Soil Vapor Monitoring Point (Hydrogen Sulfide)
- SOW-12 ○ Optional SOW
- 1000 [shaded box] Benzene Concentration in Groundwater Contour (ug/l) (Contour Interval Not Equal) (10/01)

NOTE: UPGRADIENT AND DOWNGRADIENT WELL LOCATIONS ARE RELATIVE TO THE SULFATE ADDITION ZONE




Pilot Study Work Plan for Enhancing the Biodegradation of Benzene through Sulfate Addition to Groundwater
 Amoco Oil Company, Neodesha, KS (AM061-15705-612)

CONCEPTUAL PILOT SYSTEM LAYOUT

DATE: 10/03/02 DRWN: E.S.S.

FIGURE A-1

1. S. P. ...

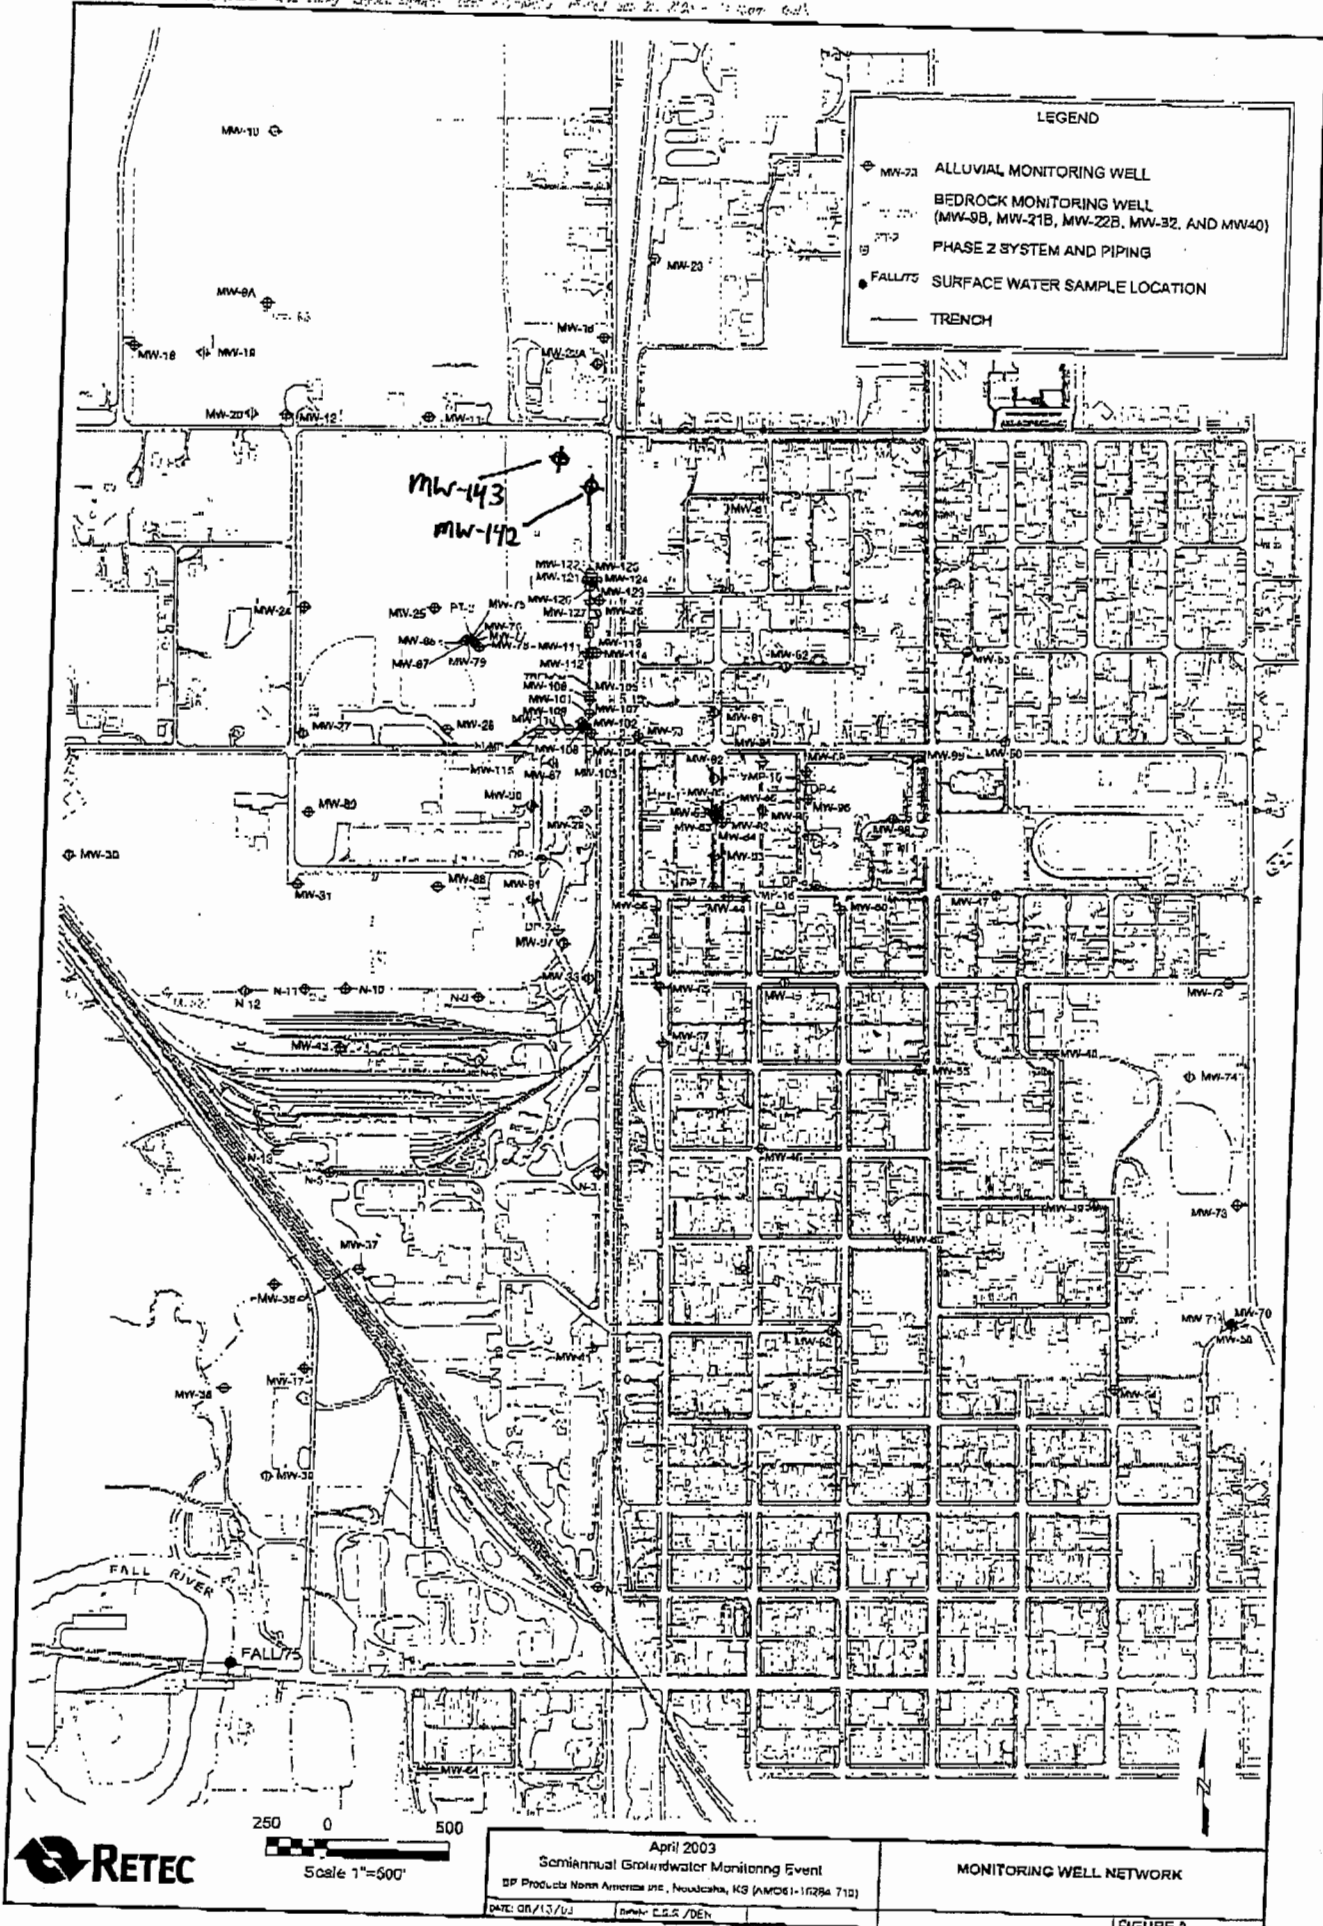

250 0 500
Scale 1"=500'

April 2003
Semiannual Groundwater Monitoring Event
DATE: 08/13/03 BY: C.S.S./DEN

MONITORING WELL NETWORK

FIGURE 2