


1 LOCATION OF WATER WELL:	Fraction	Section Number	Township Number	Range Number
County: Wilson	SE ¼ NW ¼ NW ¼	20	30S	16E

Distance and direction from nearest town or city street address of well if located within city?

See map

2 WATER WELL OWNER: **BP Amoco Oil Co.**
 RR#, St. Address, Box # **1100 North 12th Street** Board of Agriculture, Division of Water Resources
 City, State, ZIP Code : **Neodesha, Kansas 66757** Application Number: **Not Applicable**

3 MARK WELL'S LOCATON WITH AN "X" IN SECTION BOX:

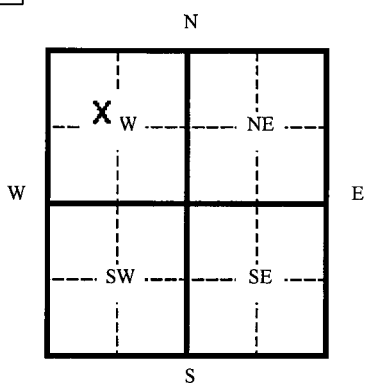

4 DEPTH OF WELL 27 ft.
 WELL'S STATIC WATER LEVEL Unk. ft.
 WELL WAS USED AS:
 1 Domestic 5 Public Water Supply 9 Dewatering
 2 Irrigation 6 Oil Field Water Supply 10 Monitoring Well
 3 Feedlot 7 Lawn and Garden (domestic) 11 Injection Well
 4 Industrial 8 Air Conditioning 12 Other _____

Was a chemical/bacteriological sample submitted to Department? Yes _____ No X
 If yes, mo/day/yr sample was submitted _____
 Water Well Disinfected: Yes _____ No X

5 TYPE OF BLANK CASING USED:
 1 Steel 3 RMP (SR) 5 Wrought 7 Fiberglass 9 Other (specify below)
 2 PVC 4 ABC 6 Asbestos-Cement 8 Concrete Tile

Blank casing diameter 2 in. Was casing pulled? Yes X No _____ If yes, how much 27 ft.
 Casing height above or below land surface 0 in.

6 GROUT PLUG MATERIAL: 1 Neat cement 2 Cement grout 3 Bentonite 4 Other _____

Grout Plug Intervals From 0 ft. to 27 ft. From _____ ft. to _____ ft. From _____ ft. to _____ ft.

What is the nearest source of possible contamination:
 1 Septic tank 6 Seepage pit 11 Fuel storage 16 Other (specify below)
 2 Sewer lines 7 Pit privy 12 Fertilizer storage
 3 Watertight sewer lines 8 Sewage lagoon 13 Insecticide storage
 4 Lateral lines 9 Feedyard 14 Abandoned water well
 5 Cess Pool 10 Livestock pens 15 Oil well/ Gas well

Direction from well? Northwest How many feet? 1,500

FROM	TO	CODE	PLUGGING MATERIALS
0	27	-	bentonite

7 CONTRACTOR'S OR LANDOWNER'S CERTIFICATION: This water well was plugged under my jurisdiction and was completed on (mo/day/yr) 11/30/05 and this record is true to the best of my knowledge and belief. Kansas Water Well Contractor's License No. 616 This Water Well Record was completed on (mo/day/yr) 3/7/06 under the business name of Thiele Geotech, Inc. by (signature) *[Signature]*

INSTRUCTIONS: Please fill in blanks and circle the correct answers. Send three copies to Kansas Department of Health and Environment, Bureau of Water, 1000 S W Jackson St., Ste. 420, Topeka, Kansas 66620-0001. Telephone: 785-296-3565. Send one to Water Well Owner and retain one for your records.

F-369



T-818 P.002

9133621044

From: Retec KC

14:25

11-12-02

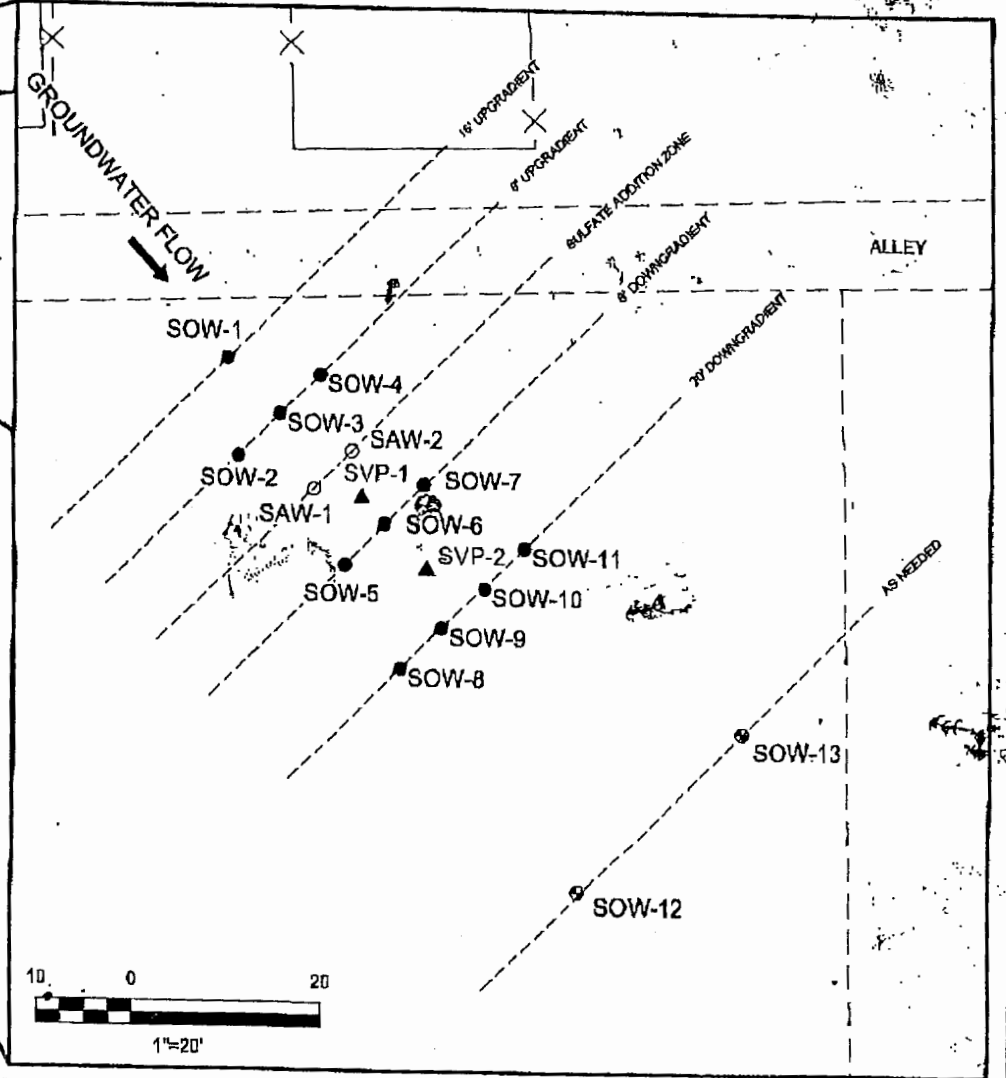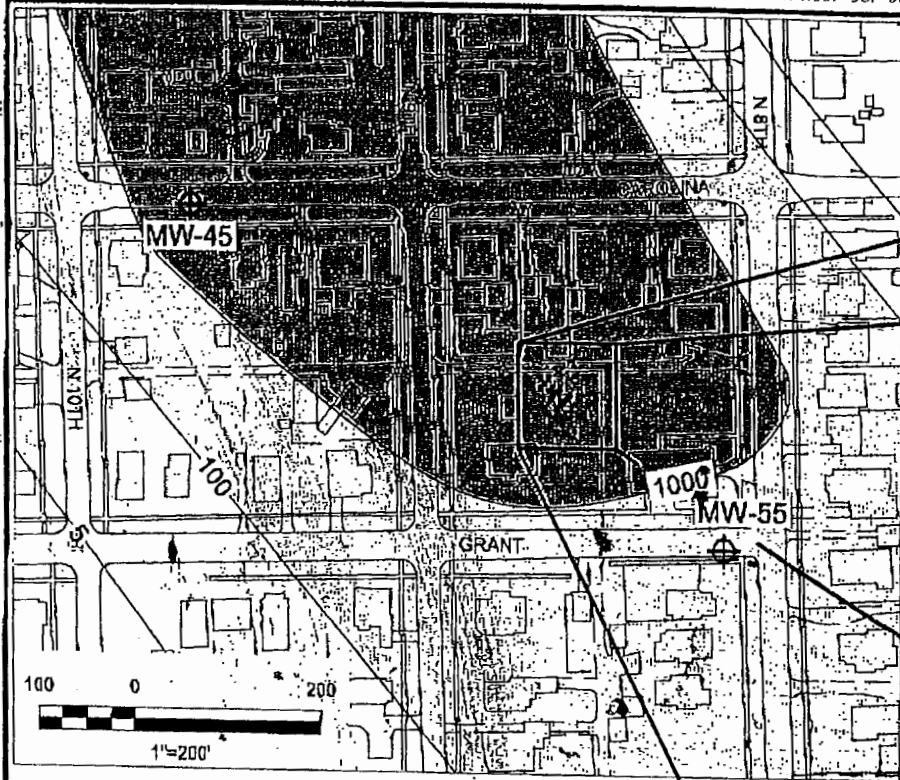

LEGEND

- SAW-1 SULFATE ADDITION WELL
- SOW-5 SULFATE MONITORING WELL
- SVP-2 SOIL VAPOR MONITORING POINT (HYDROGEN SULFIDE)
- SOW-12 OPTIONAL SOW
- 1000 BENZENE CONCENTRATION IN GROUNDWATER CONTOUR (ug/l) (CONTOUR INTERVAL NOT EQUAL) (10/01)

NOTE: UPGRADIENT AND DOWNGRADIENT WELL LOCATIONS ARE RELATIVE TO THE SULFATE ADDITION ZONE



Pilot Study Work Plan for Enhancing the Biodegradation of Benzene through Sulfate Addition to Groundwater
Ampco Oil Company, Neodesha, KS (AM061-15705-612)


CONCEPTUAL PILOT SYSTEM LAYOUT

DATE: 10/03/02

DRWN: E.S.S.

FIGURE A-1

1. S. P. ...

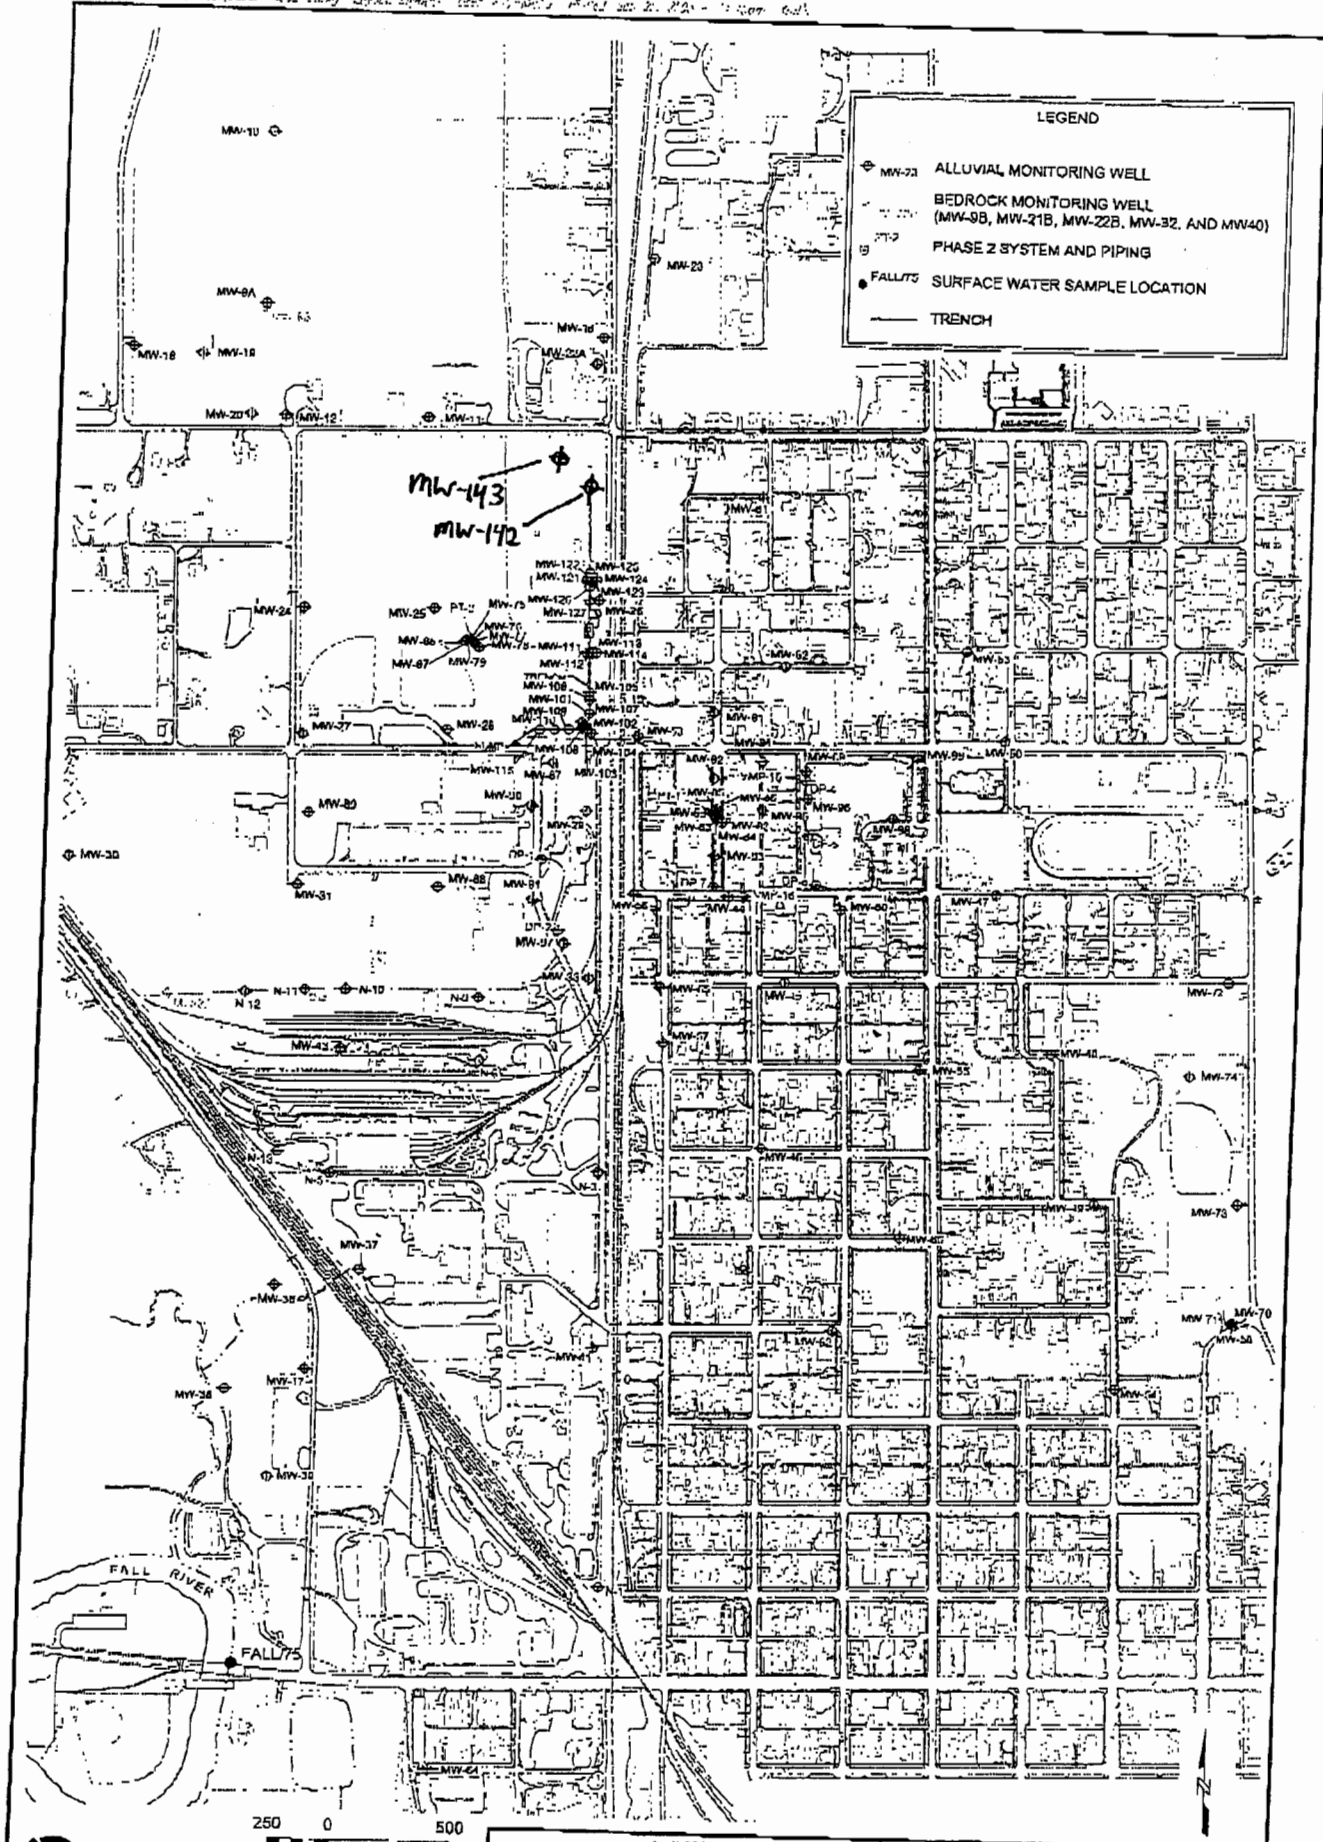

LEGEND

- MW-21 ALLUVIAL MONITORING WELL
- ⊗ BEDROCK MONITORING WELL (MW-9B, MW-21B, MW-22B, MW-32, AND MW-40)
- - - PHASE 2 SYSTEM AND PIPING
- FALLITS SURFACE WATER SAMPLE LOCATION
- TRENCH

MW-143
MW-142

April 2003
Semiannual Groundwater Monitoring Event
SP Products North America Inc., Nowata, KS (AWC61-10284 710)
DATE: 08/13/03

MONITORING WELL NETWORK

FIGURE 2