

WATER WELL RECORD

Form WWC-5

Division of Water Resources App. No.


Well ID

KMW6

Original Record Correction Change in Well Use

1 LOCATION OF WATER WELL: County Wilson Fraction NW 1/4 NE 1/4 SW 1/4 SW 1/4 Section Number 20 Township Number T 30 S Range Number R 16 E

2 WELL OWNER: Last Name: Business: Greenfield Env. Multistate Trust L.L.C. Address: 1400 Village Sq. Blvd., Ste. 3-144 City Tallahassee State: FL ZIP: 32312 Street or Rural Address where well is located (if unknown, distance and direction from nearest town or intersection): 903 Main St., Neodesha, KS

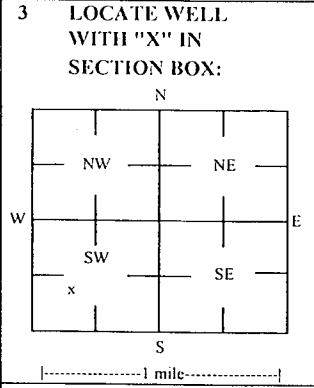

4 DEPTH OF COMPLETED WELL: 16.5 ft. Depth(s) Groundwater Encountered: 1) 16.5 ft. 2) ft 3) ft or 4) Dry Well. WELL'S STATIC WATER LEVEL: 8.2 ft. below land surface, measured on (mo-day-yr) 6/11/20.

5 Latitude: 37.41740 (decimal degrees) Longitude: 95.68503 (decimal degrees) Horizontal Datum: WGS 84. Source for Latitude/Longitude: GPS (unit make/model).

6 Elevation: 805.49 ft. Ground Level TOC. Source: Land Survey GPS Topographic Map.

7 WELL WATER TO BE USED AS: 1 Domestic: Household, Lawn & Garden, Livestock, Irrigation, Feedlot, Industrial. 5 Public Water Supply: well ID. 6 Dewatering: how many wells? 7 Aquifer Recharge: well ID. 8 Monitoring: well ID KMW6. 9 Environmental Remediation: well ID. 10 Oil Field Water Supply: lease. 11 Test Hole: well ID. 12 Geothermal: How many bores? a) Closed Loop Horizontal Vertical. b) Open Loop Surface Discharge Inj. of Water.

Was a chemical/bacteriological sample submitted to KDHE? Yes No. If yes, date sample was submitted: Water well disinfected? Yes No.

8 TYPE OF CASING USED: Steel PVC Other. CASING JOINTS: Glued Clamped Welded Threaded. Casing diameter 2 in. to 4.5 ft. Diameter in. to ft. Casing height above land surface -0.44 in. Weight lbs./ft. Well thickness or gauge No. TYPE OF SCREEN OR PERFORATION MATERIAL: Steel Stainless Steel Fiberglass PVC Other. SCREEN OR PERFORATION OPENINGS ARE: Continuous Slot Mill Slot Gauze Wrapped Torch Cut Drilled Holes Other. SCREEN-PERFORATED INTERVALS: From 4.5 ft. to 16.5 ft. GRAVEL PACK INTERVALS: From 2.5 ft. to 16.5 ft.

9 GROUT MATERIAL: Neat cement Cement grout Bentonite Other Concrete: 0-0.5'. Grout intervals: From 0.5 ft. to 2.5 ft. From ft. to ft. From ft. to ft.

Nearest source of possible contamination: Septic Tank Lateral Lines Pit Privy Livestock Pens Insecticide Storage. Sewer Lines Cess Pool Sewage Lagoon Fuel Storage Abandoned Water Well. Watertight Sewer Lines Seepage Pit Feedyard Fertilizer Storage Oil Well / Gas Well. Other (Specify). Direction from well? SW Distance from well? ~30 ft.

Table with 6 columns: FROM, TO, LITHOLOGIC LOG, FROM, TO, LITHO. LOG (cont.) or PLUGGING INTERVALS. Rows show depth intervals and lithology: Grass/topsoil, Silty clay, Clayey silt, Clayey silt, sandstone cobbles, Sandstone.

Notes: KDHE ID: Kerr-McGee #6465; U3-103-00198. Target of monitoring well is shallow groundwater, <20' of grout was installed at the direction of KDHE.

11 CONTRACTOR'S OR LANDOWNER'S CERTIFICATION: This water well was constructed reconstructed or plugged under my jurisdiction and was completed on (mo-day-year) 6/10/20 and this record is true to the best of my knowledge and belief. Kansas Water Well Contractor's License No. 757 This Water Well Record was completed on (mo-day-year) 7/7/20 under the business name of Larsen & Associates, Inc. Signature