WATER WELL RECORD Form WWC-5 KSA 82a-1212 MW-1

| 1 LOCATION OF WATER WELL: County: Wilson | Fraction: NE ¼ NE ¼ NE ¼ | Section Number: 19 | Township Number: T 30 (S) | Range Number: R 16 (E) W |
|---|---|---|---|---|

Distance and direction from nearest town or city street address of well if located within city? 1/2 mile west of Neodasha Ks on south side

2 WATER WELL OWNER: Williams Pipeline

RR#, St. Address, Box # :

City, State, ZIP Code : Neodasha Ks

Board of Agriculture, Division of Water Resources Application Number:

3 LOCATE WELL'S LOCATION WITH AN "X" IN SECTION BOX:

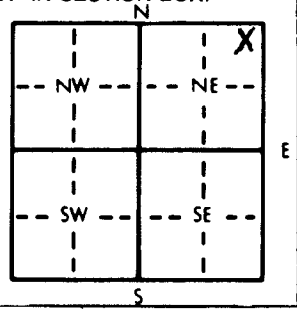


4 DEPTH OF COMPLETED WELL 19.0 ft. ELEVATION: —

Depth(s) Groundwater Encountered 1. 15 ft. 2. — ft. 3. — ft.

WELL'S STATIC WATER LEVEL — ft. below land surface measured on mo/day/yr —

Pump test data: Well water was — ft. after — hours pumping — gpm

Est. Yield — gpm: Well water was — ft. after — hours pumping — gpm

Bore Hole Diameter 6" in. to 19.0 ft., and — in. to — ft.

WELL WATER TO BE USED AS: 5 Public water supply 8 Air conditioning 11 Injection well; 1 Domestic 3 Feedlot 6 Oil field water supply 9 Dewatering 12 Other (Specify below); 2 Irrigation 4 Industrial 7 Lawn and garden only (10) Monitoring well

Was a chemical/bacteriological sample submitted to Department? Yes ..... No X ; If yes, mo/day/yr sample was submitted

Water Well Disinfected? Yes No X

5 TYPE OF BLANK CASING USED: 5 Wrought iron 8 Concrete tile CASING JOINTS: Glued Clamped

1 Steel 3 RMP (SR) 6 Asbestos-Cement 9 Other (specify below) Welded X

(2) PVC 4 ABS 7 Fiberglass Threaded

Blank casing diameter 8" in. to 9 ft., Dia — in. to — ft., Dia — in. to — ft.

Casing height above land surface 8.4" in., weight Sch 40 lbs./ft. Wall thickness or gauge No. —

TYPE OF SCREEN OR PERFORATION MATERIAL: (7) PVC 10 Asbestos-cement

1 Steel 3 Stainless steel 5 Fiberglass 8 RMP (SR) 11 Other (specify)

2 Brass 4 Galvanized steel 6 Concrete tile 9 ABS 12 None used (open hole)

SCREEN OR PERFORATION OPENINGS ARE: 5 Gauzed wrapped 8 Saw cut 11 None (open hole)

1 Continuous slot (3) Mill slot 6 Wire wrapped 9 Drilled holes

2 Louvered shutter 4 Key punched 7 Torch cut 10 Other (specify) —

SCREEN-PERFORATED INTERVALS: From 9.0 ft. to 19.0 ft., From — ft. to — ft.

From — ft. to — ft., From — ft. to — ft.

GRAVEL PACK INTERVALS: From 8.0 ft. to 19.0 ft., From — ft. to — ft.

From — ft. to — ft., From — ft. to — ft.

6 GROUT MATERIAL: (1) Neat cement 2 Cement grout (3) Bentonite 4 Other

Grout Intervals: From 0.0 ft. to 8.0 ft., From ft. to ft., From ft. to ft.

What is the nearest source of possible contamination: 10 Livestock pens 14 Abandoned water well

1 Septic tank 4 Lateral lines 7 Pit privy (11) Fuel storage 15 Oil well/Gas well

2 Sewer lines 5 Cess pool 8 Sewage lagoon 12 Fertilizer storage 16 Other (specify below)

3 Watertight sewer lines 6 Seepage pit 9 Feedyard 13 Insecticide storage

Direction from well? How many feet?

| FROM | TO | LITHOLOGIC LOG | FROM | TO | PLUGGING INTERVALS |
|---|---|---|---|---|---|
| 0.0 | 1.25 | Dark Gray silty Loam | | | |
| 1.25 | 7.0 | Gray to Br mottled Gr to olive Gr silty clay | | | |
| 7.0 | 19.0 | Gr to Br mottled Gr to olive Gr silty clay w/ gr | | | |

7 CONTRACTOR'S OR LANDOWNER'S CERTIFICATION: This water well was (1) constructed, (2) reconstructed, or (3) plugged under my jurisdiction and was completed on (mo/day/year) 3/17/93 and this record is true to the best of my knowledge and belief. Kansas Water Well Contractor's License No. 416 This Water Well Record was completed on (mo/day/yr) under the business name of Terracon Consultants Inc by (signature) Richard D Murphy

INSTRUCTIONS: Use typewriter or ball point pen. *PLEASE PRESS FIRMLY* and *PRINT* clearly. Please fill in blanks, underline or circle the correct answers. Send top three copies to Kansas Department of Health and Environment, Bureau of Water, Topeka, Kansas 66620-7320. Telephone: 913-296-5545. Send one to WATER WELL OWNER and retain one for your records.

OFFICE USE ONLY T R E/W SEC. ¼ ¼ ¼