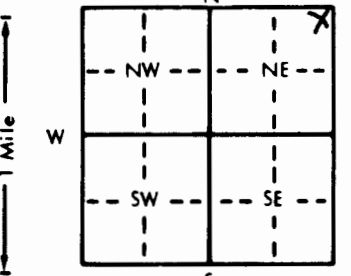


1 LOCATION OF WATER WELL: County: <u>Wilson</u>	Fraction <u>NE 1/4 NE 1/4 NE 1/4</u>	Section Number <u>19</u>	Township Number T <u>30 S</u>	Range Number R <u>16 EW</u>
--	---	-----------------------------	----------------------------------	--------------------------------

Distance and direction from nearest town or city street address of well if located within city?
1/2 mile west of Neodasha Ks. on south side

2 WATER WELL OWNER: Williams Pipeline
 RR#, St. Address, Box # : _____
 City, State, ZIP Code : Neodasha Ks.
 Board of Agriculture, Division of Water Resources
 Application Number: _____

3 LOCATE WELL'S LOCATION WITH AN "X" IN SECTION BOX: 	4 DEPTH OF COMPLETED WELL... <u>18.0</u> ft. ELEVATION: _____ Depth(s) Groundwater Encountered 1. <u>15.0</u> ft. 2. _____ ft. 3. _____ ft. WELL'S STATIC WATER LEVEL _____ ft. below land surface measured on mo/day/yr _____ Pump test data: Well water was _____ ft. after _____ hours pumping _____ gpm Est. Yield _____ gpm: Well water was _____ ft. after _____ hours pumping _____ gpm Bore Hole Diameter... <u>6</u> in. to <u>18.0</u> ft., and _____ in. to _____ ft. WELL WATER TO BE USED AS: 5 Public water supply 8 Air conditioning 11 Injection well 1 Domestic 3 Feedlot 6 Oil field water supply 9 Dewatering 12 Other (Specify below) 2 Irrigation 4 Industrial 7 Lawn and garden only <input checked="" type="checkbox"/> Monitoring well Was a chemical/bacteriological sample submitted to Department? Yes _____ No <input checked="" type="checkbox"/> ; If yes, mo/day/yr sample was submitted _____ Water Well Disinfected? Yes _____ No <input checked="" type="checkbox"/>
--	---

5 TYPE OF BLANK CASING USED:
 1 Steel 3 RMP (SR) 5 Wrought iron 8 Concrete tile CASING JOINTS: Glued _____ Clamped _____
 PVC 4 ABS 6 Asbestos-Cement 9 Other (specify below) Welded _____
 7 Fiberglass Threaded

Blank casing diameter 9" in. to 3.0 ft., Dia _____ in. to _____ ft., Dia _____ in. to _____ ft.
 Casing height above land surface 2.4" in., weight Sch 40 lbs./ft. Wall thickness or gauge No. _____

TYPE OF SCREEN OR PERFORATION MATERIAL:
 PVC 10 Asbestos-cement
 1 Steel 3 Stainless steel 5 Fiberglass 8 RMP (SR) 11 Other (specify) _____
 2 Brass 4 Galvanized steel 6 Concrete tile 9 ABS 12 None used (open hole)

SCREEN OR PERFORATION OPENINGS ARE:
 1 Continuous slot Mill slot 5 Gauzed wrapped 8 Saw cut 11 None (open hole)
 2 Louvered shutter 4 Key punched 6 Wire wrapped 9 Drilled holes
 7 Torch cut 10 Other (specify) _____

SCREEN-PERFORATED INTERVALS: From 3.0 ft. to 18.0 ft., From _____ ft. to _____ ft.
 From _____ ft. to _____ ft., From _____ ft. to _____ ft.
 GRAVEL PACK INTERVALS: From 2.5 ft. to 18.0 ft., From _____ ft. to _____ ft.
 From _____ ft. to _____ ft., From _____ ft. to _____ ft.

6 GROUT MATERIAL: Neat cement 2 Cement grout Bentonite 4 Other _____
 Grout Intervals: From 2.0 ft. to 2.5 ft., From _____ ft. to _____ ft., From _____ ft. to _____ ft.

What is the nearest source of possible contamination:
 1 Septic tank 4 Lateral lines 7 Pit privy Fuel storage 10 Livestock pens 14 Abandoned water well
 2 Sewer lines 5 Cess pool 8 Sewage lagoon 12 Fertilizer storage 15 Oil well/Gas well
 3 Watertight sewer lines 6 Seepage pit 9 Feedyard 13 Insecticide storage 16 Other (specify below)

Direction from well?		LITHOLOGIC LOG		PLUGGING INTERVALS	
FROM	TO	FROM	TO	FROM	TO
0.0	1.0				
1.0	4.0		Black wet silty clay loam		
4.0	10.5		Gray Brown & Gray silty clay		
10.5	14.0		Olive Gray silty clay		
14.0	18.0		Brown mottled Gray silty clay		
			Olive Gray silty clay		

7 CONTRACTOR'S OR LANDOWNER'S CERTIFICATION: This water well was constructed, (2) reconstructed, or (3) plugged under my jurisdiction and was completed on (mo/day/year) 3/17/93 and this record is true to the best of my knowledge and belief. Kansas Water Well Contractor's License No. 416. This Water Well Record was completed on (mo/day/yr) _____ under the business name of Terracon Consultants Inc by (signature) Richard D. Murphy

OFFICE USE ONLY
T
R
EW
SEC.