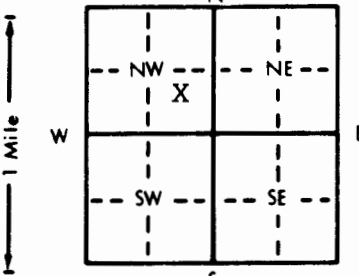


1 LOCATION OF WATER WELL: Fraction NW 1/4 SE 1/4 NW 1/4 Section Number 20 Township Number T 30 S Range Number R 16 **E/W**  
 County: Wilson

Distance and direction from nearest town or city street address of well if located within city?  
 On Grant Street, east of 7th, off the north side of the street.

2 WATER WELL OWNER: Amoco Oil ~~Company~~ Company  
 RR#, St. Address, Box #: One Prudential Plaza - 130 E. Randolph Dr. Board of Agriculture, Division of Water Resources  
 City, State, ZIP Code: Chicago, IL 60680 Application Number:

3 LOCATE WELL'S LOCATION WITH AN "X" IN SECTION BOX:  
  
 4 DEPTH OF COMPLETED WELL: 19 ft. ELEVATION:  
 Depth(s) Groundwater Encountered 1. ft. 2. ft. 3. ft.  
 WELL'S STATIC WATER LEVEL: 8.30 ft. below land surface measured on mo/day/yr 7/12/93  
 Pump test data: Well water was ft. after hours pumping gpm  
 Est. Yield gpm: Well water was ft. after hours pumping gpm  
 Bore Hole Diameter: in. to ft., and in. to ft.  
 WELL WATER TO BE USED AS:  
 1 Domestic 3 Feedlot 6 Oil field water supply 9 Dewatering 12 Other (Specify below)  
 2 Irrigation 4 Industrial 7 Lawn and garden only 10 Monitoring well MW-48  
 Was a chemical/bacteriological sample submitted to Department? Yes No **X**; If yes, mo/day/yr sample was submitted  
 Water Well Disinfected? Yes No **X**

5 TYPE OF BLANK CASING USED:  
 1 Steel 3 RMP (SR) 5 Wrought iron 8 Concrete tile CASING JOINTS: Glued Clamped  
 2 **PVC** 4 ABS 6 Asbestos-Cement 9 Other (specify below) Welded  
 7 Fiberglass Threaded  
 Blank casing diameter 2 in. to 8.5 ft., Dia. in. to ft., Dia. in. to ft.  
 Casing height above land surface 0 in., weight lbs./ft. Wall thickness or gauge No. Sch. 40  
 TYPE OF SCREEN OR PERFORATION MATERIAL:  
 1 Steel 3 Stainless steel 5 Fiberglass 7 **PVC** 10 Asbestos-cement  
 2 Brass 4 Galvanized steel 6 Concrete tile 8 RMP (SR) 11 Other (specify)  
 9 ABS 12 None used (open hole)  
 SCREEN OR PERFORATION OPENINGS ARE:  
 1 Continuous slot 3 Mill slot 5 Gauzed wrapped 8 Saw cut 11 None (open hole)  
 2 Louvered shutter 4 Key punched 6 Wire wrapped 9 Drilled holes  
 7 Torch cut 10 Other (specify) **Factory Slot**  
 SCREEN-PERFORATED INTERVALS: From 8.5 ft. to 18.5 ft., From ft. to ft.  
 GRAVEL PACK INTERVALS: From 6.5 ft. to 19 ft., From ft. to ft.

6 GROUT MATERIAL: 1 Neat cement 2 **Cement grout** 3 **Bentonite** 4 Other  
 Grout intervals: From (2) 0 ft. to 4.3 ft., From (3) 4.3 ft. to 6.5 ft., From ft. to ft.  
 What is the nearest source of possible contamination:  
 1 Septic tank 4 Lateral lines 7 Pit privy 10 Livestock pens 14 Abandoned water well  
 2 Sewer lines 5 Cess pool 8 Sewage lagoon 11 Fuel storage 15 Oil well/Gas well  
 3 Watertight sewer lines 6 Seepage pit 9 Feedyard 12 Fertilizer storage 16 **Other (specify below)**  
 13 Insecticide storage Unknown  
 Direction from well? How many feet?

FROM	TO	LITHOLOGIC LOG	FROM	TO	PLUGGING INTERVALS
0	1	Asphalt & gravel roadbase			
1	5.4	<del>Dark</del> Dark brown to lt. brown clay			
5.4	12.2	Lt. brown silty clay w/grey			
12.2	17	Lt. brown clay & gravel, fine to coarse			
17	19	Lt. brown clay w/weathered sandstone			

7 CONTRACTOR'S OR LANDOWNER'S CERTIFICATION: This water well was (1) **constructed**, (2) reconstructed, or (3) plugged under my jurisdiction and was completed on (mo/day/year) 7/9/93 and this record is true to the best of my knowledge and belief. Kansas Water Well Contractor's License No. 458. This Water Well Record was completed on (mo/day/yr) under the business name of The Winnek Co. Inc. by (signature) *Paula Lynn Bowler*

OFFICE USE ONLY  
T  
R  
E/W  
SEC.  
1/4  
1/4  
1/4