


LOCATION OF WATER WELL:		Fraction	Section Number	Township Number	Range Number
County:	Wilson	NE 1/4 NE 1/4 NE 1/4	30	T 30 S	R 16 E/W

Distance and direction from nearest town or city street address of well if located within city?

Neodesha, Kansas

WATER WELL OWNER:	Standard Oil Company	Contact:	
RR#, St. Address, Box # :	P.O. Box 591	Mr. Tony Goga1	Board of Agriculture, Division of Water Resources
City, State, ZIP Code :	Tulsa, Oklahoma 74102	(918)660-4007	Application Number:

LOCATE WELL'S LOCATION WITH AN "X" IN SECTION BOX: 4 DEPTH OF COMPLETED WELL: 20 ft. ELEVATION:
 Depth(s) Groundwater Encountered: 1 16 # 2 # 3 #

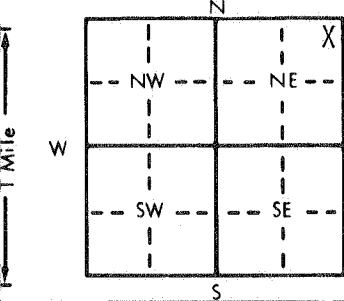

4 DEPTH OF COMPLETED WELL . . . 20 . . . ft. ELEVATION:
 Depth(s) Groundwater Encountered 1. . . 16 . . . ft. 2. ft. 3. ft.
 WELL'S STATIC WATER LEVEL . . . 16 . . . ft. below land surface measured on mo/day/yr . . . 8/19/81
 Pump test data: Well water was ft. after hours pumping gpm
 Est. Yield gpm: Well water was ft. after hours pumping gpm
 Bore Hole Diameter . . . 8 . . . in. to . . . 20 . . . ft., and in. to ft.
 WELL WATER TO BE USED AS: 5 Public water supply 8 Air conditioning 11 Injection well
 1 Domestic 3 Feedlot 6 Oil field water supply 9 Dewatering 12 Other (Specify below)
 2 Irrigation 4 Industrial 7 Lawn and garden only 10 Observation well
 Was a chemical/bacteriological sample submitted to Department? Yes No X; If yes, mo/day/yr sample was sub-
 mitted Water Well Disinfected? Yes No X

5 TYPE OF BLANK CASING USED:	5 Wrought iron	8 Concrete tile	CASING JOINTS: Glued Clamped
1 Steel	3 RMP (SR)	6 Asbestos-Cement	9 Other (specify below) Welded
2 PVC	4 ABS	7 Fiberglass	Threaded

Blank casing diameter 2 in. to 20 ft., Dia in. to ft., Dia in. to ft.
Casing height above land surface 36 in., weight lbs./ft. Wall thickness or gauge No.

TYPE OF SCREEN OR PERFORATION MATERIAL:			7 PVC	10 Asbestos-cement
1 Steel	3 Stainless steel	5 Fiberglass	<u>8 RMP (SR)</u>	11 Other (specify)
2 Brass	4 Galvanized steel	6 Concrete tile	9 ABS	12 None used (open hole)

SCREEN OR PERFORATION OPENINGS ARE:

<u>1</u> Continuous slot	3 Mill slot	5 Gauzed wrapped	8 Saw cut	11 None (open hole)
<u>2</u> Louvered shutter	4 Key punched	6 Wire wrapped	9 Drilled holes	
		7 Torch cut	10 Other (specify)	

SCREEN-PERFORATED INTERVALS: From 10 ft. to 20 ft., From ft. to ft.
From ft. to ft., From ft. to ft.
GRAVEL PACK INTERVALS: From 5 ft. to 20 ft., From ft. to ft.
From ft. to ft., From ft. to ft.

6] GROUT MATERIAL: 1 Neat cement 2 Cement grout 3 Bentonite 4 Other

Grout Intervals: From 0 ft. to 5 ft., From ft. to ft., From ft. to ft.

What is the nearest source of possible contamination:

1 Septic tank	4 Lateral lines	7 Pit privy	10 Livestock pens	14 Abandoned water well
2 Sewer lines	5 Cess pool	8 Sewage lagoon	11 Fuel storage	15 Oil well/Gas well
3 Watertight sewer lines	6 Seepage pit	9 Feedyard	12 Fertilizer storage	16 Other (specify below)

Direction from well? East

How many feet? 500

waste disposal pit for refinery

[illegible]

7 CONTRACTOR'S OR LANDOWNER'S CERTIFICATION: This water well was (1) constructed, (2) reconstructed, or (3) plugged under my jurisdiction and was completed on (mo/day/year) 8/19/81 and this record is true to the best of my knowledge and belief. Kansas Water Well Contractor's License No. _____ This Water Well Record was completed on (mo/day/yr) 11/18/81 under the business name of HEMPHILL CORPORATION by (signature) James R. Hemphill

INSTRUCTIONS: Use typewriter or ball point pen, PLEASE PRESS FIRMLY and PRINT clearly. Please fill in blanks, underline or circle the correct answers. Send top three copies to Kansas Department of Health and Environment, Division of Environment, Environmental Geology Section, Topeka, KS 66620. Send one to WATER WELL OWNER and retain one for your records.