

Constructed 3@310

**WATER WELL PLUGGING RECORD Form WWC-5P**

KSA 82a-1212

ID NO.

<b>1 LOCATION OF WATER WELL:</b> County: <u>Montgomery</u>	Fraction <u>SW 1/4 NE 1/4 NE 1/4</u>	Section Number <u>15</u>	Township Number <u>T 32 S</u>	Range Number <u>17</u> <input checked="" type="checkbox"/> E <input type="checkbox"/> W
---	---	-----------------------------	----------------------------------	--

Street/Rural Address of Well Location; if unknown, distance & direction from nearest town or intersection: If at owner's address, check here ☐

**Global Positioning Systems (GPS) information:**

Latitude: 37.263956 (in decimal degrees)

Longitude: -95.521933 (in decimal degrees)

Elevation:

Datum: ☐ WGS84, ☐ NAD83, ☐ NAD27

**Collection Method:**

☒ GPS unit (Make/Model: MAGELLAN)

☐ Digital Map/Photo, ☐ Topographic Map, ☐ Land Survey


Est. Accuracy: ☐ < 3 m, ☐ 3-5 m, ☐ 5-15 m, ☐ > 15 m

**2 WATER WELL OWNER: RASH**

RR#, St. Address, Box #: 1997 E. 5TH ST

City, State ZIP Code: CHERRYVILLE, KS 67335

**3 MARK WELL'S LOCATION WITH AN "X" IN SECTION BOX:**

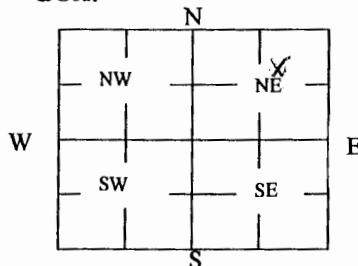

**4 DEPTH OF WELL 310 ft.**

WELL'S STATIC WATER LEVEL N/A ft

**WELL WAS USED AS:**

☐ Domestic  
☐ Irrigation  
☐ Feedlot  
☐ Industrial

☐ Public Water Supply  
☐ Oil Field Water Supply  
☐ Domestic (Lawn & Garden)  
☐ Air Conditioning

☐ Dewatering  
☐ Monitoring  
☐ Injection Well  
☒ Other Geothermal

Was a chemical/bacteriological sample submitted to Department? Yes ☐ No ☒

**5 TYPE OF BLANK CASING USED:**

☐ Steel  
☐ PVC

☐ RMP (SR)  
☐ ABS

☐ Wrought  
☐ Asbestos-Cement

☐ Fiberglass  
☐ Concrete Tile

☒ Other (Specify below)  
N/A

Blank casing diameter \_\_\_\_\_ in. Was casing pulled? Yes ☐ No ☐ If yes, how much \_\_\_\_\_

Casing height above or below land surface \_\_\_\_\_ in.

**6 GROUT PLUG MATERIAL:** ☐ Neat cement ☐ Cement grout ☒ Bentonite ☐ Other \_\_\_\_\_

Grout Plug Intervals: From 0 ft. to 310 ft., From \_\_\_\_\_ ft. to \_\_\_\_\_ ft., From \_\_\_\_\_ to \_\_\_\_\_ ft.

What is the nearest source of possible contamination:

☐ Septic tank  
☐ Sewer lines  
☐ Watertight sewer lines  
☐ Lateral lines  
☐ Cess pool

☐ Seepage pit  
☐ Pit privy  
☐ Sewage lagoon  
☐ Feedyard  
☐ Livestock pens

☐ Fuel Storage  
☐ Fertilizer storage  
☐ Insecticide storage  
☐ Abandoned water well  
☐ Oil well/Gas well

☒ Other (specify below)  
HOUSE

Direction from well? SOUTH

How many feet? 15

FROM	TO	PLUGGING MATERIALS	FROM	TO	PLUGGING MATERIALS
0	50	SANDSTONE	210	215	BLUE SHALE
50	85	BLUE SHALE	215	260	GRAY SHALE
85	95	LIMESTONE	260	270	BLUE SHALE
95	190	BLUE SHALE	270	275	GRAY SHALE
190	195	SANDSTONE	275	280	LIMESTONE
195	200	BLUE SHALE	280	310	GRAY SHALE
200	210	SANDSTONE			

**7 CONTRACTOR'S OR LANDOWNER'S CERTIFICATION:** This water well was plugged under my jurisdiction and was completed on (mo/day/year) 7/7/11 and this record is true to the best of my knowledge and belief. Kansas Water Well Contractor's License No. 812. This Water Well Record was completed on (mo/day/year) 7/12/11 under the business name of Environmental Loop Service, Inc by (signature) Richard Moore

**INSTRUCTIONS:** Use typewriter or ballpoint pen. Please press firmly and print clearly. Please fill in blanks, underline or circle the correct answers. Send top three copies to Kansas Department of Health and Environment, Bureau of Water, Geology Section, 1000 SW Jackson St., Ste. 420, Topeka, Kansas 66612-1367. Telephone: 785/296-5524. Send one to Water Well Owner and retain one for your records. Visit us at <http://www.kdheks.gov/waterwell/index.html>.

Check one: ☒ White Copy ☐ Blue Copy ☐ Pink Copy