


1 LOCATION OF WATER WELL: Sumner	FRACTION SW 1/4 SW 1/4 SW 1/4	Section Number 15	Township Number T 30 S	Range Number R 2E E/W
--	---	-----------------------------	----------------------------------	---------------------------------

Distance and direction from nearest town or city street address of well if located within city?

1574 E. 120th Ave. N. Mulvane, Kansas

2 WATER WELL OWNER: BROWN, Wayne	RR#, ST. ADDRESS, BOX #: 1574 E. 120th Ave. N.	Board of Agriculture, Division of Water Resource
CITY, STATE, ZIP CODE: Mulvane, Kansas		Application Number:

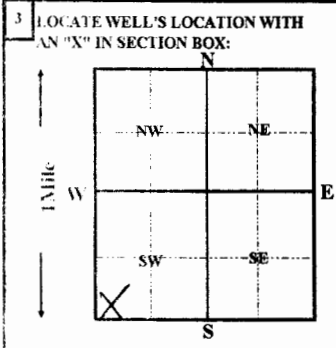

4 DEPTH OF COMPLETED WELL 50 ft.	ELEVATION: 08/30/1995
Depth(s) groundwater Encountered 1 ft.	2 ft. 3 ft.
WELL'S STATIC WATER LEVEL 20 FT. BELOW LAND SURFACE MEASURED ON	mo/day/yr
Pump test data: Well water was	ft. after hours pumping gpm
Est. Yield gpm:	Well water was ft. after hours pumping gpm
Bore Hole Diameter 12 in. to 50 ft.	and in. to ft.
WELL WATER TO BE USED AS:	5 Public water supply 8 Air conditioning 11 Injection well
1 Domestic 3 Feedlot 6 Oil field water supply 9 Dewatering 12 Other (Specify below)	
2 Irrigation 4 Industrial 7 Lawn and garden only 10 Monitoring well	
Was a chemical/bacteriological sample submitted to Department? Yes	No <input checked="" type="checkbox"/> ; If yes, mo/day/yr sample was submitted
Water Well Disinfected? Yes <input checked="" type="checkbox"/>	No

5 TYPE OF CASING USED:	5 Wrought iron	8 Concrete tile	CASING JOINTS: Glued <input checked="" type="checkbox"/> Clamped
1 Steel 3 RMP (SR)	6 Asbestos-Cement	9 Other (Specify below)	Welded
2 PVC 4 ABS	7 Fiberglass	SDR-26	Threaded
Blank casing Diameter 5 in. to 24 ft., Dia	in. to ft., Dia	in. to ft.	
Casing height above land surface 12 in., weight 2.35 lbs. / ft.	Wall thickness or gauge No. .214		
TYPE OF SCREEN OR PERFORATION MATERIAL:	7 PVC	10 Asbestos-cement	
1 Steel 3 Stainless Steel	5 Fiberglass	8 RMP (SR)	11 other (specify)
2 Brass 4 Galvanized steel	6 Concrete tile	9 ABS	12 None used (open hole)
SCREEN OR PERFORATION OPENING ARE:	5 Gauzed wrapped	8 Saw cut	11 None (open hole)
1 Continuous slot 3 Mill slot	6 Wire wrapped	9 Drilled holes	
2 Louvered shutter 4 Key punched	7 Torch cut	10 Other (specify)	
SCREEN-PERFORATION INTERVALS:	from 24 ft. to 50 ft., From	ft. to ft.	
GRAVEL PACK INTERVALS:	from 24 ft. to 50 ft., From	ft. to ft.	

6 GROUT MATERIAL: 1 Neat cement	2 Cement grout	3 Bentonite	4 Other
Grout Intervals: From 4 ft. to 24 ft. From	ft. From	ft. to ft. From	ft. to ft.
What is the nearest source of possible contamination:	10 Livestock pens	14 Abandon water well	
1 Septic tank 4 Lateral lines	7 Pit privy	11 Fuel storage	15 Oil well/Gas well
2 Sewer lines 5 Cess pool	8 Sewage lagoon	12 Fertilizer storage	16 Other (specify below)
3 Watertight sewer lines 6 Seepage pit	9 Feedyard	13 Insecticide storage	None Apparent

FROM	TO	LITHOLOGIC LOG	FROM	TO	PLUGGING INTERVALS
0	4	topsoil			
4	8	clay			
8	20	fine sand			
20	30	medium coarse sand			
30	35	clay			
35	45	medium sand			
45	50	red shale			

7 CONTRACTOR'S OR LANDOWNER'S CERTIFICATION: This water well was (1) constructed, (2) reconstructed, or (3) plugged under my jurisdiction and was completed on (mo/day/year) 08/30/1995 and this record is true to the best of my knowledge and belief. Kansas Water Well Contractor's License No. 236 This Water Well Record was completed on (mo/day/yr) 08/31/95 Under the business name of Harp Well & Pump Service, Inc by (signature) <i>Jane Frederick</i>
