


**WATER WELL RECORD Form WWC-5 KSA 82a-1212**

1 LOCATION OF WATER WELL: <b>Sumner</b>	FRACTION <b>SE 1/4 SW 1/4 SW 1/4</b>	SECTION NUMBER <b>32</b>	TOWNSHIP NUMBER <b>T 30 S</b>	RANGE NUMBER <b>R 2E E/W</b>
--	---	-----------------------------	----------------------------------	---------------------------------

Distance and direction from nearest town or city street address of well if located within city?  
**1416 E. 90th Belle Plain, Kansas (2 1/4 E. of Belle Plain on Hwy 55-N. side of the road)**

2 WATER WELL OWNER: <b>BAILEY, Vicki</b>	Board of Agriculture, Division of Water Resource
RR#, ST. ADDRESS, BOX #: <b>1416 E. 90th</b>	Application Number:
CITY, STATE: <b>Belle Plain, Kansas</b>	ZIP CODE: <b>67013</b>

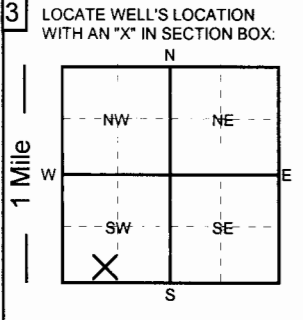

4 DEPTH OF COMPLETED WELL: <b>47</b> ft. ELEVATION:	
Depth of groundwater Encountered: _____ ft.	
WELL'S STATIC WATER LEVEL <b>15</b> FT. BELOW LAND SURFACE MEASURED ON <b>6/13/05</b>	
Pump test data:	Well water was _____ ft. after _____ hours of pumping @ _____ gpm
Est. Yield:	Well water was _____ ft. after _____ hours of pumping @ _____ gpm
Bore Hole Diameter <b>12</b> in.	to <b>47</b> ft. and _____ in. to _____ ft.
WELL WATER TO BE USED AS:	
<input checked="" type="checkbox"/> 1. Domestic	<input type="checkbox"/> 3. Feedlot <input type="checkbox"/> 5. Public water supply <input type="checkbox"/> 7. Lawn and garden only <input type="checkbox"/> 9. Dewatering <input type="checkbox"/> 11. Injection well
<input type="checkbox"/> 2. Irrigation <input type="checkbox"/> 4. Industrial <input type="checkbox"/> 6. Oil field water supply <input type="checkbox"/> 8. Air conditioning <input type="checkbox"/> 10. Monitoring well	<input type="checkbox"/> 12. Other (Specify below)
Was a chemical/bacteriological sample submitted to Department? <b>YES</b> <input checked="" type="checkbox"/> <b>NO</b>	
Was Water Well Disinfected? <input checked="" type="checkbox"/> <b>YES</b> <input type="checkbox"/> <b>NO</b>	

5 TYPE OF CASING USED:		5. Wrought Iron		7. Fiberglass		9. Other (Specify below)		CASING JOINTS: <input checked="" type="checkbox"/> <b>Glued</b> <input type="checkbox"/> Threaded	
<input checked="" type="checkbox"/> 1. Steel		<input type="checkbox"/> 3. RPM (SR)		<input type="checkbox"/> 8. Concrete tile		<input type="checkbox"/> SDR-26		<input type="checkbox"/> Welded <input type="checkbox"/> Clamped	
<input checked="" type="checkbox"/> 2. PVC		<input type="checkbox"/> 4. ABS		<input type="checkbox"/> 6. Asbestos-Cement					
Blank casing diameter <b>5</b> in.		to <b>32</b> ft., Dia.		in. to _____ ft., Dia.		in. to _____ ft.			
Casing height above land surface: <b>12</b> in.,		Weight: <b>5.52</b> lbs. / ft.		Wall thickness or gauge No. <b>.332</b>					
TYPE OF SCREEN OR PERFORATION MATERIAL:									
<input type="checkbox"/> 1. Steel		<input type="checkbox"/> 3. Stainless Steel		<input type="checkbox"/> 5. Fiberglass		<input checked="" type="checkbox"/> 7. PVC		<input type="checkbox"/> 9. ABS	
<input type="checkbox"/> 2. Brass		<input type="checkbox"/> 4. Galvanized		<input type="checkbox"/> 6. Concrete Tile		<input type="checkbox"/> 8. RMP (SR)		<input type="checkbox"/> 10. Asbestos-Cement	
<input type="checkbox"/> 11. Other (specify)		<input type="checkbox"/> 12. None used (open hole)							
SCREEN OR PERFORATION OPENINGS ARE:									
<input type="checkbox"/> 1. Continuous slot		<input type="checkbox"/> 3. Mill slot		<input type="checkbox"/> 5. Gauzed wrapped		<input type="checkbox"/> 7. Torch cut		<input type="checkbox"/> 9. Drilled holes	
<input type="checkbox"/> 2. Louvered shutter		<input type="checkbox"/> 4. Key punched		<input type="checkbox"/> 6. Wire wrapped		<input checked="" type="checkbox"/> 8. Saw cut		<input type="checkbox"/> 10. Other (specify)	
<input type="checkbox"/> 11. None (open hole)									
SCREEN - PERFORATION INTERVAL									
From <b>32</b> ft.		to <b>47</b> ft.,		From _____ ft.		to _____ ft.		From _____ ft.	
From _____ ft.		to _____ ft.,		From _____ ft.		to _____ ft.		From _____ ft.	
GRAVEL PACK INTERVALS:									
From <b>24</b> ft.		to <b>47</b> ft.,		From _____ ft.		to _____ ft.		From _____ ft.	
From _____ ft.		to _____ ft.,		From _____ ft.		to _____ ft.		From _____ ft.	

6 GROUT MATERIALS:		1. Neat cement		2. Cement Grout		3. Bentonite		Other <b>bentonite hole plug</b>	
Grout Intervals: From <b>4</b> ft.		to <b>24</b> ft.,		From _____ ft.		to _____ ft.,		From _____ ft. to _____ ft.	
What is the nearest source of possible contamination:									
<input checked="" type="checkbox"/> 1. Septic tank		<input type="checkbox"/> 4. Lateral lines		<input type="checkbox"/> 7. Pit privy		<input type="checkbox"/> 10. Livestock pens		<input type="checkbox"/> 13. Insecticide storage	
<input type="checkbox"/> 2. Sewer lines		<input type="checkbox"/> 5. Cess Pool		<input type="checkbox"/> 8. Sewage lagoon		<input type="checkbox"/> 11. Fuel storage		<input type="checkbox"/> 14. Abandon water well	
<input type="checkbox"/> 3. Watertight sewer line		<input type="checkbox"/> 6. Seepage pit		<input type="checkbox"/> 9. Feed yard		<input type="checkbox"/> 12. Fertilizer storage		<input type="checkbox"/> 15. Oil well/Gas well	
Direction from well? <b>Northeast</b>								<input type="checkbox"/> 16. Other (specify below)	
								How many feet? <b>100 ft. plus</b>	

From	To	LITHOLOGIC LOG	From	To	LITHOLOGIC LOG
0	4	fine sand			
4	15	clay			
15	30	fine sand			
30	47	coarse sand			

7 Contractor's or Landowner's Certification: This water well was 1. <input checked="" type="checkbox"/> <b>constructed</b> 2. <input type="checkbox"/> <b>reconstructed</b> or 3. <input type="checkbox"/> <b>plugged</b> under my jurisdiction and was completed on (mo/day/year) <b>6/13/2005</b> and this record is true to the best of my knowledge and belief.	
Kansas Water Well Contractor's License No. <b>236</b>	This water well record was completed on (mo/day/year) <b>6/15/2005</b>
under the business name of <b>Harp Well &amp; Pump Service Inc.</b>	by (signature) <i>Jo d d S. Harp</i>