


1 LOCATION OF WATER WELL: County: Sumner Fraction: $\frac{1}{4}$ NE $\frac{1}{4}$ NW Section Number: 18 Township Number: T 30 S Range Number: R 02 EW

Distance and direction from nearest town or city street address of well if located within city?
From Belle Plain, KS: 4 3/4 m N / 1 1/2 m E

2 WATER WELL OWNER: Twyla Hoobler Wagner
 RR#, St. Address, Box #: 1345 E 130th Board of Agriculture, Division of Water Resources
 City, State, ZIP Code: Mulvane, KS 67110 Application Number: 5180

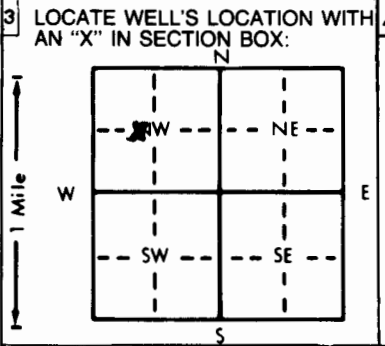

4 DEPTH OF COMPLETED WELL: 55 ft. ELEVATION: _____ ft.
 Depth(s) Groundwater Encountered 1. 10 ft. 2. _____ ft. 3. _____ ft.
 WELL'S STATIC WATER LEVEL: 10 ft. below land surface measured on mo/day/yr 8-11-00
 Pump test data: Well water was _____ ft. after _____ hours pumping _____ gpm
 Est. Yield 1000 gpm: Well water was _____ ft. after _____ hours pumping _____ gpm
 Bore Hole Diameter: 30 in. to 55 ft., and _____ in. to _____ ft.
 WELL WATER TO BE USED AS: 5 Public water supply 8 Air conditioning 11 Injection well
 1 Domestic 3 Feedlot 6 Oil field water supply 9 Dewatering 12 Other (Specify below)
0 Irrigation 4 Industrial 7 Lawn and garden only 10 Monitoring well
 Was a chemical/bacteriological sample submitted to Department? Yes _____ No X; If yes, mo/day/yr sample was submitted _____
 Water Well Disinfected? Yes X No _____

5 TYPE OF BLANK CASING USED: 1 Steel 3 RMP (SR) 5 Wrought iron 8 Concrete tile CASING JOINTS: Glued X Clamped _____
 2 Brass 4 Galvanized steel 6 Asbestos-Cement 9 Other (specify below) Welded _____
0 PVC 1 ABS 7 Fiberglass _____ Threaded _____
 Blank casing diameter: 16 in. to 35 ft., Dia _____ in. to _____ ft., Dia _____ in. to _____ ft.
 Casing height above land surface: 12 in., weight 16 lbs./ft. Wall thickness or gauge No. 1/2"
 TYPE OF SCREEN OR PERFORATION MATERIAL: 0 PVC 10 Asbestos-cement
 1 Steel 3 Stainless steel 5 Fiberglass 8 RMP (SR) 11 Other (specify) _____
 2 Brass 4 Galvanized steel 6 Concrete tile 9 ABS 12 None used (open hole)
 SCREEN OR PERFORATION OPENINGS ARE: 5 Gauzed wrapped 8 Saw cut 11 None (open hole)
 1 Continuous slot 0 Mill slot 6 Wire wrapped 9 Drilled holes
 2 Louvered shutter 4 Key punched 7 Torch cut 10 Other (specify) _____
 SCREEN-PERFORATED INTERVALS: From 35 ft. to 55 ft., From _____ ft. to _____ ft.
 From _____ ft. to _____ ft., From _____ ft. to _____ ft.
 GRAVEL PACK INTERVALS: From 20 ft. to 55 ft., From _____ ft. to _____ ft.
 From _____ ft. to _____ ft., From _____ ft. to _____ ft.

6 GROUT MATERIAL: 1 Neat cement 2 Cement grout 3 Bentonite 4 Other _____
 Grout Intervals: From 0 ft. to 28 ft., From _____ ft. to _____ ft., From _____ ft. to _____ ft.
 What is the nearest source of possible contamination: 10 Livestock pens 0 Abandoned water well
 1 Septic tank 4 Lateral lines 7 Pit privy 11 Fuel storage 15 Oil well/Gas well
 2 Sewer lines 5 Cess pool 8 Sewage lagoon 12 Fertilizer storage 16 Other (specify below)
 3 Watertight sewer lines 6 Seepage pit 9 Feedyard 13 Insecticide storage
 Direction from well? West How many feet? 1300

FROM	TO	LITHOLOGIC LOG	FROM	TO	PLUGGING INTERVALS
<u>0</u>	<u>3</u>	<u>Topsoil</u>			
<u>3</u>	<u>10</u>	<u>Dark Clay</u>			
<u>10</u>	<u>18</u>	<u>Fine Sand</u>			
<u>18</u>	<u>55</u>	<u>Good Gravel</u>			
<u>55</u>		<u>Shale</u>			

7 CONTRACTOR'S OR LANDOWNER'S CERTIFICATION: This water well was (1) constructed, (2) reconstructed, or (3) plugged under my jurisdiction and was completed on (mo/day/year) 8-8-00 and this record is true to the best of my knowledge and belief. Kansas Water Well Contractor's License No. 238 This Water Well Record was completed on (mo/day/yr) 8-20-00 under the business name of Weninger Irrigation by (signature) Twyla Wagner

OFFICE USE ONLY