

County: Sumner Fraction: NENW NE SE Sec. 5 T. 30 S R. 2 ~~E~~

CORRECTION(S) to WATER WELL COMPLETION RECORD Form WWC-5 (to rectify lacking or incorrect information)

Owner: Molvane Mobile Home Park

If location corrected, was listed as:

Section-Township-Range: 4-30S-2E

Fraction (1/4 calls): NW1/4, SW1/4, NW1/4

Location changed to:

5-30S-2E

NE1/4, NW1/4, NE1/4, SE1/4

Other changes: Initial statements:

No address or directions to well provided

Changed to: Well near trees, SW of Westend of E. Martin Lane

Comments: Lat. 37.469298° ; Long. -97.225018°

Verification method: On-site confirmation by KDHE/BOW and Herb Janzen;
Google Earth (H.D. WSG 84) 10/13/16


Initials: PKC Date: 11/7/16

Submitted by: Kansas Geological Survey, Data Resources Library, 1930 Constant Ave., Lawrence, KS 66047-3726
 Kansas Dept. of Health & Environment, Bureau of Water, 1000 SW Jackson, Suite 420, Topeka, KS 66612-1367

1	LOCATION OF WATER WELL: County: <u>Sumner</u>	Fraction <u>NW 1/4 SW 1/4 NW 1/4</u>	Section Number <u>4</u>	Township Number <u>30</u>	Range Number <u>R 2 E</u>
---	--	---	----------------------------	------------------------------	------------------------------

Distance and direction from nearest town or city street address of well if located within city?

2 WATER WELL OWNER: Mulvane Mobile Home Park
 RR #, St. Address, Box #: 1455 N. Webb Rd,
 City, State, ZIP Code : Mulvane, KS, 67110
 Board of Agriculture, Division of Water Resources
 Application Number: 18086

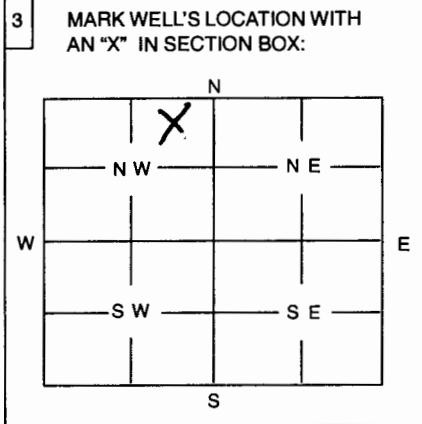

4 DEPTH OF WELL 38 ft
 WELL'S STATIC WATER LEVEL 12 ft.

WELL WAS USED AS:

1 Domestic	<u>5 Public Water Supply</u>	9 Dewatering
2 Irrigation	6 Oil Field Water Supply	10 Monitoring Well
3 Feedlot	7 Domestic (Lawn & Garden)	11 Injection Well
4 Industrial	8 Air Conditioning	12 Other

Was a chemical / bacteriological sample submitted to Department? Yes No X.....
 If yes, mo/day/yr sample was submitted

Water Well Disinfected: Yes No X.....

5 TYPE OF BLANK CASING USED:

1 Steel	3 RMP (SR)	5 Wrought	7 Fiberglass	9 Other (Specify below)
<u>2 PVC</u>	4 ABS	6 Asbestos-Cement	8 Concrete Tile

Blank casing diameter 5 in. Was casing pulled? Yes No X If yes, how much

Casing height above or below land surface 3.6 in.

6 GROUT PLUG MATERIAL: 1 Neat cement 2 Cement grout 3 Bentonite 4 Other

Grout Plug Intervals: From 38 ft. to 3 ft., From 3 ft. to 0 ft., From to ft.

What is the nearest source of possible contamination:

<u>1 Septic tank</u>	6 Seepage pit	11 Fuel storage	16 Other (specify below)
<u>2 Sewer lines</u>	7 Pit privy	12 Fertilizer storage
3 Watertight sewer lines	8 Sewage lagoon	13 Insecticide storage	
4 Lateral lines	9 Feedyard	14 Abandoned water well	
5 Cess Pool	10 Livestock pens	15 Oil well/Gas well	

Direction from well? East How many feet? 100 ft

FROM	TO	PLUGGING MATERIALS
<u>38</u>	<u>3</u>	<u>Bentonite 6 cuft</u>
<u>3</u>	<u>0</u>	<u>Clay + Silt</u>

7 CONTRACTOR'S OR LANDOWNER'S CERTIFICATION: This water well was plugged under my jurisdiction and was completed on (mo/day/year) 11-14-06 and this record is true to the best of my knowledge and belief. Kansas Water Well Contractor's License No. 1-29-07 under the business name of Mulvane Mobile Home Park This Water Well Record was completed on (mo/day/year) by (signature) Harb Jansen

INSTRUCTIONS: Use typewriter or ball point pen. Please press firmly and print clearly. Please fill in blanks, underline or circle the correct answers. Send top three copies to Kansas Department of Health and Environment, Bureau of Water, Topeka, Kansas 66620-0001. Telephone: 785/296-3565. Send one to Water Well Owner and retain one for your records.