


|   |                                   |                            |                               |                           |
|---|-----------------------------------|----------------------------|-------------------------------|---------------------------|
| <b>1 LOCATION OF WATER WELL:</b><br>County: <b>Sumner</b> | Fraction<br><b>NE ¼ NE ¼ NE ¼</b> | Section Number<br><b>6</b> | Township Number<br><b>30S</b> | Range Number<br><b>2E</b> |
|---|-----------------------------------|----------------------------|-------------------------------|---------------------------|

Distance and direction from nearest town or city street address of well if located within city?  
 Northwest Corner of Intersection of 3<sup>rd</sup> and Main, Mulvane, KS

|   |  |
|---|--|
| <b>2 WATER WELL OWNER:</b> Charles L. Storey<br><br>RR#, St. Address, Box #: 30922 Sunnyside Dr.<br><br>City, State, ZIP Code: Manhattan, KS 66502-1922 | <b>Global Positioning System</b> (decimal degrees, min. of 4 digits)<br>Latitude: _____<br>Longitude: _____<br>Elevation: _____<br>Datum: <u>above mean sea level</u><br>Data Collection Method: <u>Legal survey</u> |
|---|--|

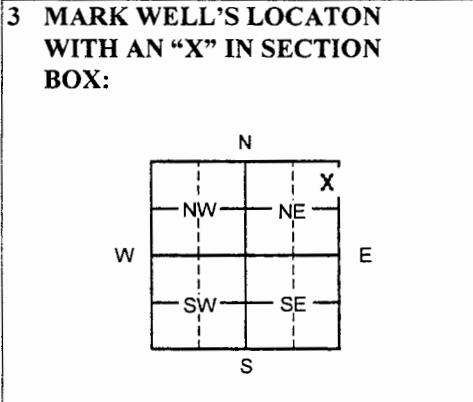

**4 DEPTH OF WELL** 14.4 ft.  
 \_\_\_\_\_  
**MW5**  
 WELL'S STATIC WATER LEVEL \_\_\_\_\_ ft.

WELL WAS USED AS:

|              |                            |  |
|--------------|----------------------------|--|
| 1 Domestic   | 5 Public Water Supply      | 9 Dewatering                                   |
| 2 Irrigation | 6 Oil Field Water Supply   | <input checked="" type="radio"/> 10 Monitoring |
| 3 Feedlot    | 7 Domestic (Lawn & Garden) | 11 Injection Well                              |
| 4 Industrial | 8 Air Conditioning         | 12 Other _____                                 |

Was a chemical/bacteriological sample submitted to Department? Yes \_\_\_ No

**5 TYPE OF BLANK CASING USED:**

|  |            |                   |                 |                               |
|--|------------|-------------------|-----------------|-------------------------------|
| 1 Steel                                | 3 RMP (SR) | 5 Wrought         | 7 Fiberglass    | 9 Other (specify below) _____ |
| <input checked="" type="radio"/> 2 PVC | 4 ABS      | 6 Asbestos-Cement | 8 Concrete Tile |                               |

Blank casing diameter 2 in. Was casing pulled? Yes  No \_\_\_ If yes, how much 3ft  
 Casing height above or below land surface 0 in.

**6 GROUT PLUG MATERIAL:** 1 Neat cement 2 Cement grout  3 Bentonite  4 Other Soil: 0-3'

Grout Plug Intervals: From 3 ft. to 14.4 ft., From \_\_\_\_\_ ft. to \_\_\_\_\_ ft., From \_\_\_\_\_ ft. to \_\_\_\_\_ ft.

- What is the nearest source of possible contamination:
- |                          |                   |                         |                                |
|--------------------------|-------------------|-------------------------|--------------------------------|
| 1 Septic tank            | 6 Seepage pit     | 11 Fuel storage         | 16 Other (specify below) _____ |
| 2 Sewer lines            | 7 Pit privy       | 12 Fertilizer storage   |                                |
| 3 Watertight sewer lines | 8 Sewage lagoon   | 13 Insecticide storage  |                                |
| 4 Lateral lines          | 9 Feedyard        | 14 Abandoned water well | Direction from well? _____     |
| 5 Cess pool              | 10 Livestock pens | 15 Oil well/Gas well    | How many feet? _____           |

| FROM | TO   | PLUGGING MATERIALS | FROM | TO | PLUGGING MATERIALS |
|------|------|--------------------|------|----|--------------------|
| 0    | 3    | Soil               |      |    |                    |
| 3    | 14.4 | Bentonite          |      |    |                    |
|      |      |                    |      |    |                    |
|      |      |                    |      |    |                    |
|      |      |                    |      |    |                    |

**7 CONTRACTOR'S OR LANDOWNER'S CERTIFICATION:** This water well was plugged under my jurisdiction and was completed on (mo/day/year) 6/29/09 and this record is true to the best of my knowledge and belief. Kansas Water Well Contractor's License No. 757. This Water Well Record was completed on (mo/day/year) 7/8/09 under the business name of Larsen and Associates, Inc. by (signature) \_\_\_\_\_

**INSTRUCTIONS:** Please fill in blanks or circle the correct answers. Send top three copies to Kansas Department of Health and Environment, Bureau of Water, Geology Section, 1000 SW Jackson St., Ste. 420, Topeka, Kansas 66612-1367. Telephone: 785/296-5522. Send one to Water Well Owner and retain one for your records. Visit us at <http://www.kdheks.gov/waterwell>.