

WATER WELL PLUGGING RECORD Form WWC-5P

KSA 82a-1212

ID NO.

MW-2

1 LOCATION OF WATER WELL: County: Sumner Fraction NW 1/4 NW 1/4 SE 1/4 NE 1/4 Section Number 6 Township Number T 30 S Range Number 2 [X] E [] W

Street/Rural Address of Well Location; if unknown, distance & direction from nearest town or intersection: If at owner's address, check here [] 211 South First Street, Mulvane, KS

Global Positioning Systems (GPS) information:

Latitude: 37.47230 (in decimal degrees)

Longitude: -97.24438 (in decimal degrees)

Elevation: 1230.89 feet amsl

Datum: [X] WGS84, [] NAD83, [] NAD27

Collection Method:


[] GPS unit (Make/Model: _____)

[X] Digital Map/Photo, [] Topographic Map, [] Land Survey

Est. Accuracy: [] < 3 m, [] 3-5 m, [] 5-15 m, [] > 15 m

2 WATER WELL OWNER: Robert Papenhaus RR#, St. Address, Box #: 511 Emery Street City, State ZIP Code: Mulvane, Kansas 67110

3 MARK WELL'S LOCATION WITH AN "X" IN SECTION BOX:

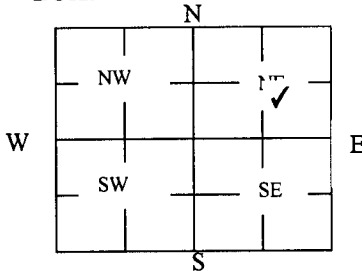

4 DEPTH OF WELL 14.80 ft.

WELL'S STATIC WATER LEVEL 8.74 ft

WELL WAS USED AS:

- [] Domestic [] Public Water Supply [X] Dewatering
[] Irrigation [] Oil Field Water Supply [] Monitoring
[] Feedlot [] Domestic (Lawn & Garden) [] Injection Well
[] Industrial [] Air Conditioning [] Other

Was a chemical/bacteriological sample submitted to Department? Yes [] No [X]

5 TYPE OF BLANK CASING USED:

- [] Steel [X] PVC [] RMP (SR) [] ABS [] Wrought [] Asbestos-Cement [] Fiberglass [] Concrete Tile [] Other (Specify below)

Blank casing diameter 2 in. Was casing pulled? Yes [X] No [] If yes, how much 3 feet Casing height above or below land surface in.

6 GROUT PLUG MATERIAL: [] Neat cement [] Cement grout [X] Bentonite [] Other

Grout Plug Intervals: From 3 ft. to 14.80 ft., From ft. to ft., From to ft.

What is the nearest source of possible contamination:

- [] Septic tank [] Sewer lines [] Watertight sewer lines [] Lateral lines [] Cess pool
[] Seepage pit [] Pit privy [] Sewage lagoon [] Feedyard [] Livestock pens
[X] Fuel Storage [] Fertilizer storage [] Insecticide storage [] Abandoned water well [] Oil well/Gas well
[] Other (specify below)
Direction from well? How many feet?

Table with 6 columns: FROM, TO, PLUGGING MATERIALS, FROM, TO, PLUGGING MATERIALS. Row 1: 0, 0.5, Gravel. Row 2: 0.5, 3, Silt/Clay. Row 3: 3, 14.80, Bentonite.

7 CONTRACTOR'S OR LANDOWNER'S CERTIFICATION: This water well was plugged under my jurisdiction and was completed on (mo/day/year) 2/17/2011 and this record is true to the best of my knowledge and belief. Kansas Water Well Contractor's License No. 708. This Water Well Record was completed on (mo/day/year) 2/22/2011 under the business name of Aquaterra Environmental Solutions, Inc. by (signature) [Signature]

INSTRUCTIONS: Use typewriter or ballpoint pen. Please press firmly and print clearly. Please fill in blanks, underline or circle the correct answers. Send top three copies to Kansas Department of Health and Environment, Bureau of Water, Geology Section, 1000 SW Jackson St., Ste. 420, Topeka, Kansas 66612-1367. Telephone: 785/296-5524. Send one to Water Well Owner and retain one for your records. Visit us at http://www.kdheks.gov/waterwell/index.html.

Check one: [X] White Copy [] Blue Copy [] Pink Copy