


1 LOCATION OF WATER WELL: Fraction S 1/4 SE 1/4 SE 1/4 NE 1/4 Section Number 5 Township Number T 30 S Range Number R 2 E E W
 County: SUMNER

Street/Rural Address of Well Location; if unknown, distance & direction from nearest town or intersection: If at owner's address, check here 155 ft. N. of E. MARTIN LANE & 350 ft. W. of N. Webb Rd.
Global Positioning Systems (GPS) information:
 Latitude: 37.469909 (in decimal degrees)
 Longitude: -97.22330 (in decimal degrees)
 Elevation: _____
 Horizontal Datum: WGS84, NAD83, NAD27
 Collection Method: _____

2 WATER WELL OWNER: BRUCE SIMPSON GPS unit (Make/Model): _____
 RR#, St. Address, Box #: 23407 HARPERGATE DR. Digital Map/Photo, Topographic Map, Land Survey
 City, State ZIP Code: SPRING, TX 77373 Est. Accuracy: < 3 m, 3-5 m, 5-15 m, > 15 m

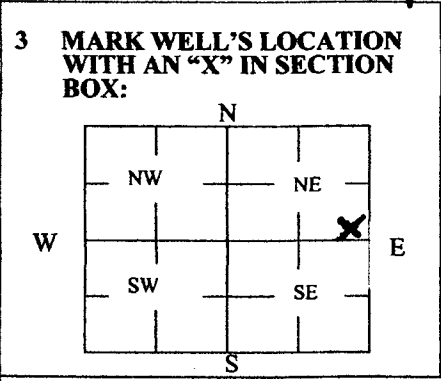

4 DEPTH OF WELL 41 ft.
WELL'S STATIC WATER LEVEL 23 ft.
WELL WAS USED AS:
 Domestic Public Water Supply Dewatering
 Irrigation Oil Field Water Supply Monitoring
 Feedlot Domestic (Lawn & Garden) Injection Well
 Industrial Air Conditioning Other _____
 Was a chemical/bacteriological sample submitted to Department? Yes No

5 TYPE OF BLANK CASING USED:
 Steel RMP (SR) Wrought Fiberglass Other (Specify below)
 PVC ABS Asbestos-Cement Concrete Tile
 Blank casing diameter 6 in. Was casing pulled? Yes No If yes, how much _____
 Casing height above or below land surface 36 in. Below

6 GROUT PLUG MATERIAL: Neat cement Cement grout Bentonite Other SAND & GRAVEL
 Grout Plug Intervals: From 41 ft. to 25 ft., From 25 ft. to 1 ft., From 1 ft. to 0 ft.

What is the nearest source of possible contamination:
 Septic tank Seepage pit Fuel storage Other (specify below)
 Sewer lines Pit privy Fertilizer storage
 Watertight sewer lines Sewage lagoon Insecticide storage
 Lateral lines Feedyard Abandoned water well Direction from well? _____
 Cess pool Livestock pens Oil well/Gas well How many feet? _____

FROM	TO	PLUGGING MATERIALS	FROM	TO	PLUGGING MATERIALS
41 ft	25 ft	SAND & GRAVEL	25 ft	24 ft	gROUT
24 ft	1 ft	BENTONITE			
1 ft	top of casing	Cement grout			

7 CONTRACTOR'S OR LANDOWNER'S CERTIFICATION: This water well was plugged under my jurisdiction and was completed on (mo/day/year) 10/21/2016 and this record is true to the best of my knowledge and belief. Kansas Water Well Contractor's License No. HERB JANDER Water Well Record was completed on (mo/day/year) 10/21/2016 under the business name of MULVANE MOBILE HOME PARK by (signature) Bruce Simpson

Send one white copy to Kansas Department of Health & Environment, Geology Section, 1000 SW Jackson Street, Ste. 420, Topeka, KS 66612-1367. Send one copy to WATER WELL OWNER and retain one for your records.
 Visit us at <http://www.kdheks.gov/waterwell/index.html> Telephone 785-296-5524.