

WATER WELL RECORD Form WWC-5☐ Original Record ☐ Correction ☐ Change in Well Use

Division of Water
Resources App. No.

Well ID

[illegible]

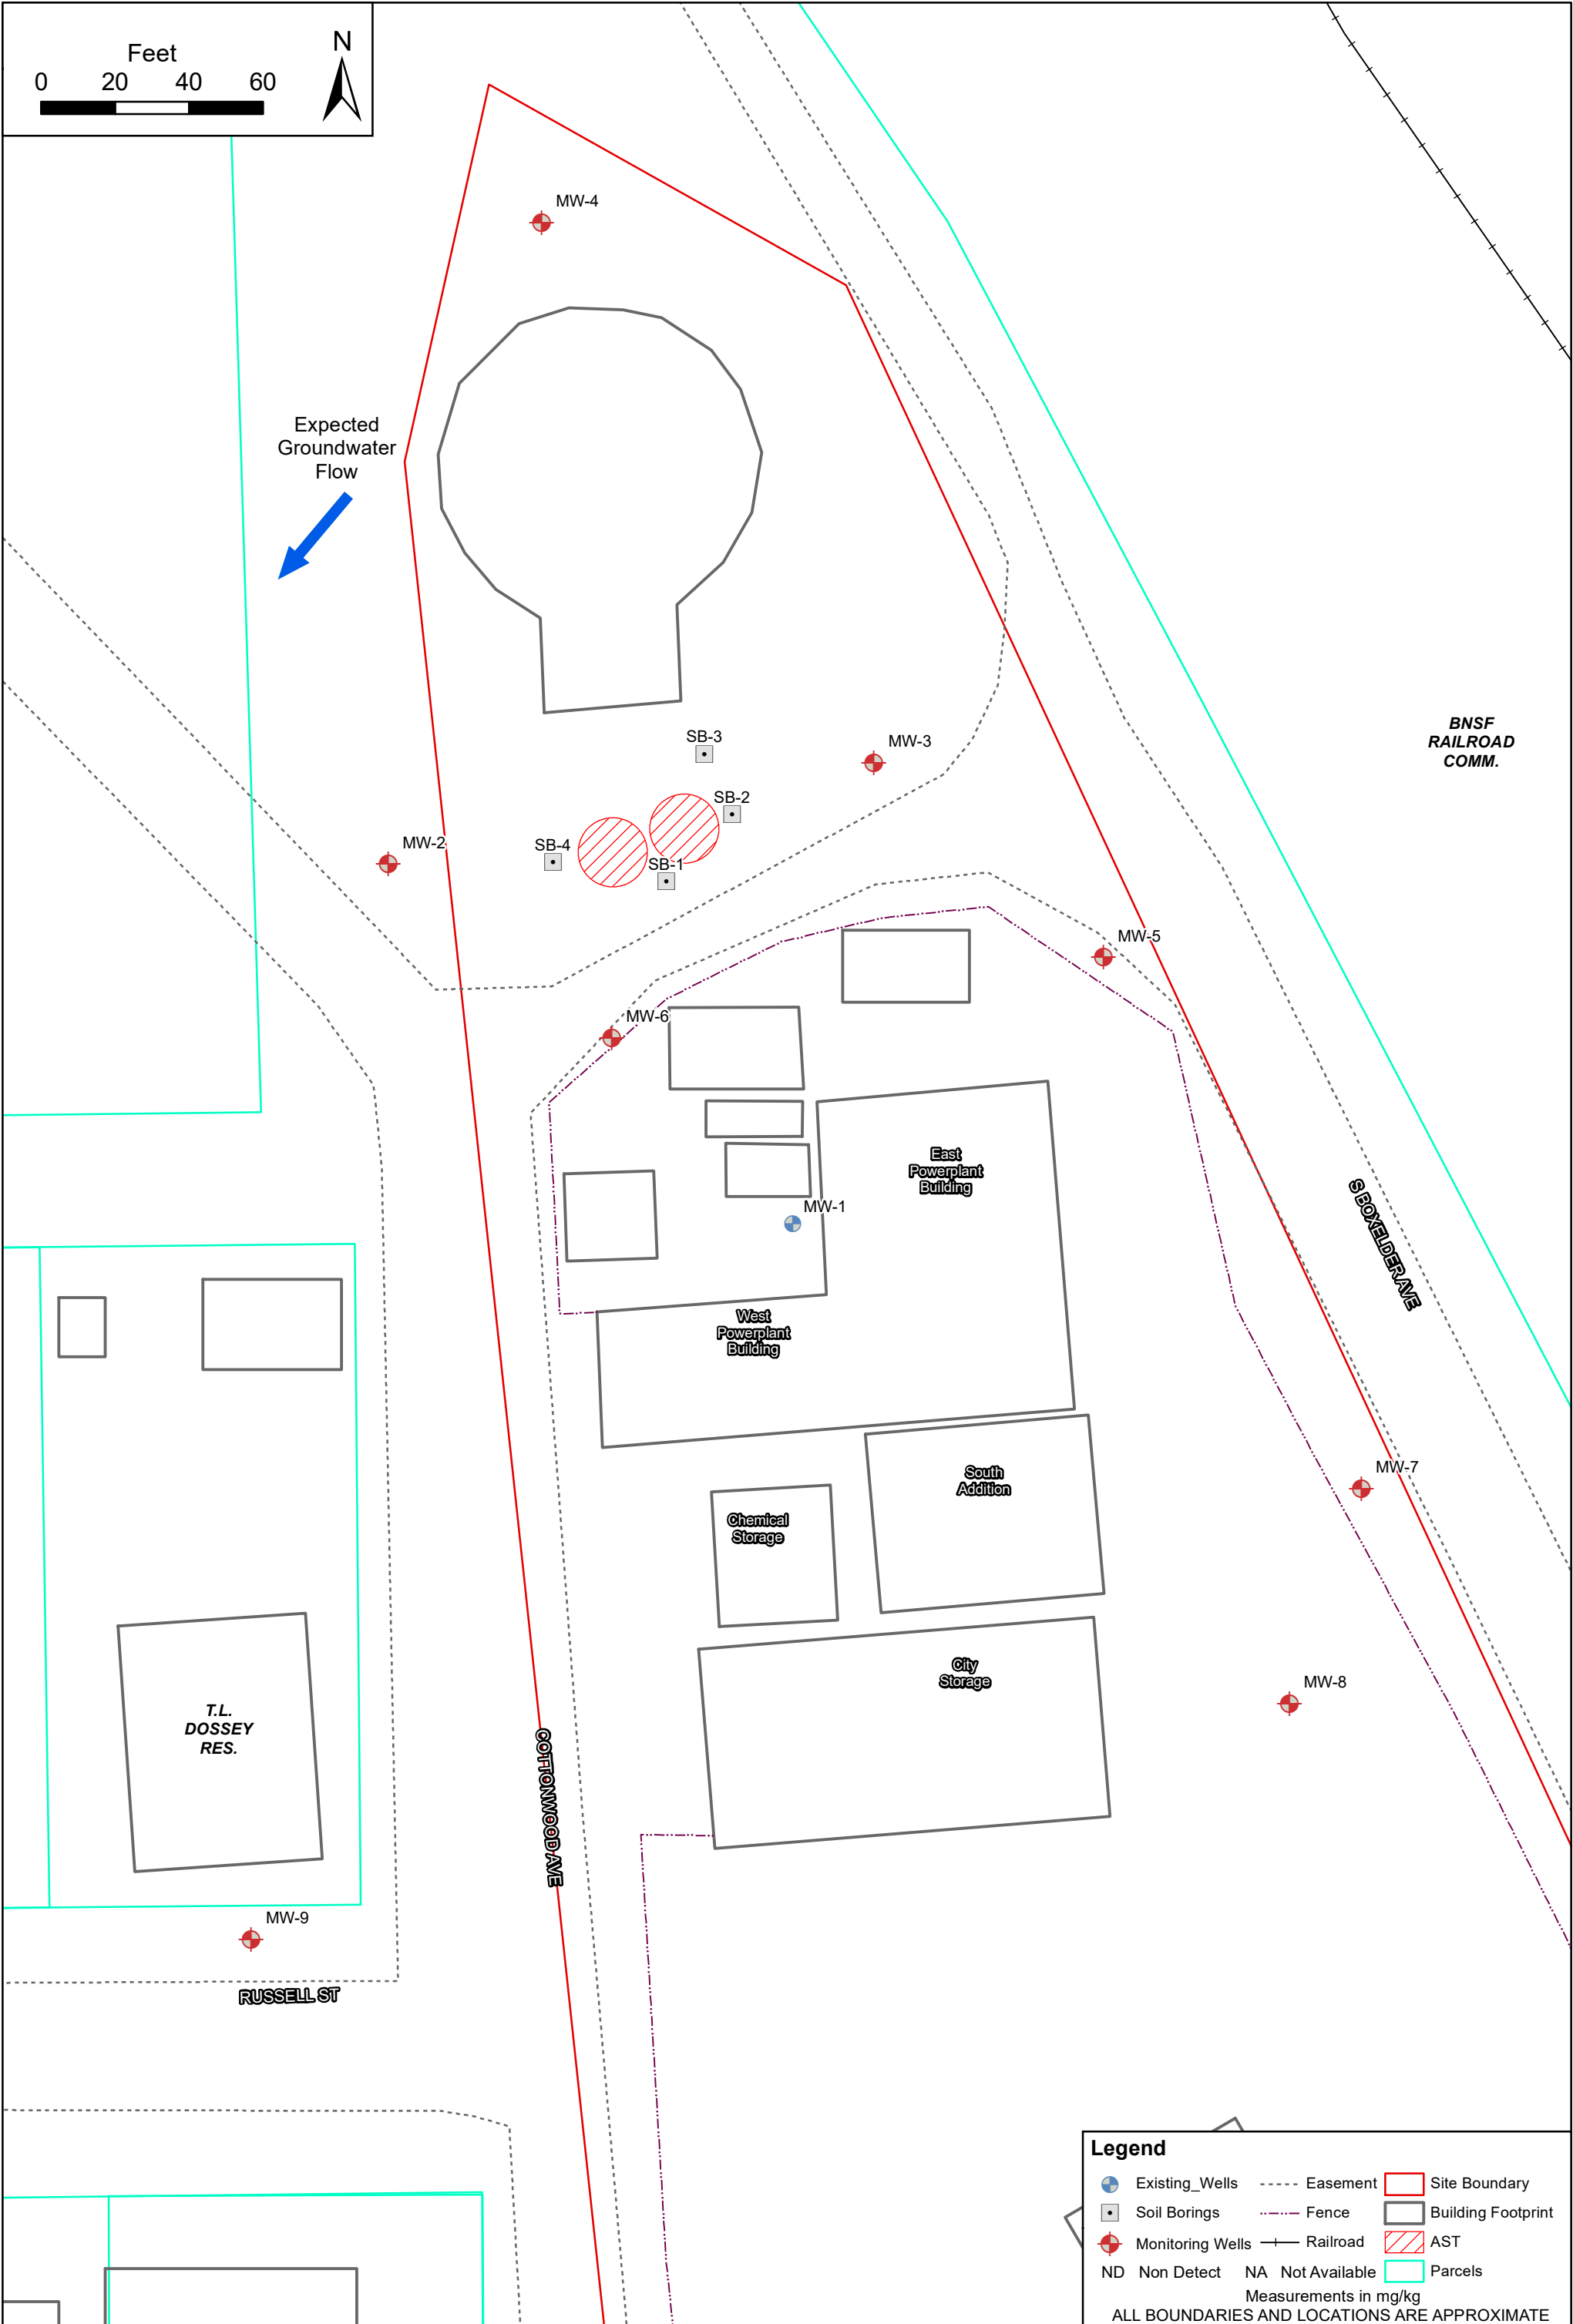


	FIGURE: 2.0	FIGURE NAME: Site Base Map	Boxelder Power Plant 102 S. Boxelder Ave. Mulvane, Kansas KDHE#: A2-096-40495
	DATE: 01/28/20	PROJECT NUMBER: 1974111	
	MADE BY: CN	PROJECT MANAGER: D.Roy	