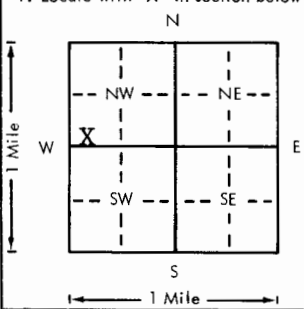


USE TYPEWRITER OR BALL
POINT PEN-PRESS FIRMLY,
PRINT CLEARLY.

WATER WELL RECORD
KSA 82a-1201-1215

Kansas Department of Health and
Environment-Division of Environment
(Water well Contractors)
Topeka, Kansas 66620

1. Location of well:		County SUMNER	Section SW 1/4 SW 1/4 NW 1/4	Section number 4	Township number T 30 S R 2E	Range number 2E
2. Distance and direction from nearest town or city:		1 mile E. of Mulvane, Owner of well: Steve Church				
Street address of well location if in city:		Kans., 1/2 mile So. of Hwy 53rd. R.R. or street: 1010 E. Harry City, state, zip code: Wichita, Kansas				
4. Locate with "X" in section below:		Sketch map:				6. Bore hole dia. 11 in. Completion date _____ Well depth 40 ft. 5-7-79
						7. ☐ Cable tool ☒ Rotary ☐ Driven ☐ Dug ☐ Hollow rod ☐ Jetted ☐ Bored ☐ Reverse rotary
5. Type and color of material						8. Use: ☒ Domestic ☐ Public supply ☐ Industry ☐ Irrigation ☐ Air conditioning ☐ Stock ☐ Lawn ☐ Oil field water ☐ Other
						9. Casing: Material Styrene Height: Above or below _____ Threaded _____ Welded gl Surface 12 in. RMP ☒ PVC _____ Weight _____ lbs./ft. Dia. 5 in. to 40 ft. depth Wall Thickness: inches or _____ Dia. _____ in. to _____ ft. depth Gauge No. .200
						10. Screen: Manufacturer's name _____ Sunflower Plastic Type Styrene Dia. 5" Slot gully .06 Length 25' Set between 15 ft. and 40 ft. _____ ft. and _____ ft. Gravel pack? yes Size range of material 1/4-1/8"
						11. Static water level: _____ mo./day/yr. 13 ft. below land surface Date 5-7-79
						12. Pumping level below land surfaces: _____ ft. after _____ hrs. pumping _____ g.p.m. _____ ft. after _____ hrs. pumping _____ g.p.m. Estimated maximum yield _____ g.p.m.
						13. Water sample submitted: _____ mo./day/yr. _____ Yes _____ No Date _____
						14. Well head completion: capped _____ Pitless adapter 12 Inches above grade
						15. Well grouted? yes 1-2 Fine Sand Mix With: _____ Neat cement _____ Bentonite ☒ Concrete Depth: From 40' ft. to 14 ft.
						16. Nearest source of possible contamination: Septic Tank ft. 75 Direction No. Type _____ Well disinfected upon completion? ☒ Yes _____ No
						17. Pump: ☒ Not installed Manufacturer's name _____ Model number _____ HP _____ Volts _____ Length of drop pipe _____ ft. capacity _____ g.p.m. Type: _____ Submersible _____ Turbine _____ Jet _____ Reciprocating _____ Centrifugal _____ Other
		(Use a second sheet if needed)				
18. Elevation:	19. Remarks: Flat Ground					20. Water well contractor's certification: This well was drilled under my jurisdiction and this report is true to the best of my knowledge and belief. Harp Well & Pump 236 Business name _____ License No. _____ Address Wichita, Kansas 67209 Signed M. Arnold Date 5-7-79 Authorized representative
Topography: _____ Hill _____ Slope _____ Upland _____ Valley						

Forward the white, blue and pink copies to the Department of Health and Environment

Form WWC-5