


1 LOCATION OF WATER WELL: Sumner	FRACTION NW 1/4 SE 1/4 NE 1/4	Section Number 5	Township Number T 30 S	Range Number R 2E E/W
--	---	----------------------------	----------------------------------	---------------------------------

Distance and direction from nearest town or city street address of well if located within city?

1/4 S. of K-15, 1/4 W. of Webb. Rd., S. Mulvane, Kansas

2 WATER WELL OWNER: RR#, ST. ADDRESS, BOX #: CITY, STATE, ZIP CODE:	LOW, Richard R#1 Box 4656B Mulvane, Kansas 67110	Board of Agriculture, Division of Water Resource Application Number:
---	---	---

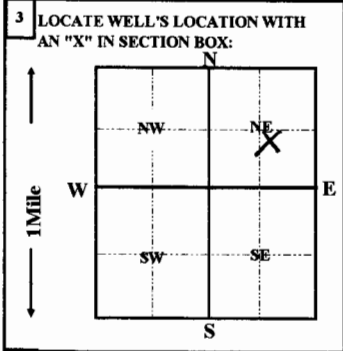

4 DEPTH OF COMPLETED WELL	70	ft.	ELEVATION:	
Depth(s) groundwater Encountered	1	ft.		
WELL'S STATIC WATER LEVEL	20	FT. BELOW LAND SURFACE MEASURED ON	09/21/1992	mo/day/yr
Pump test data:	Well water was	ft. after	hours pumping	gpm
Est. Yield	gpm:	Well water was	ft. after	hours pumping
Bore Hole Diameter	12	in. to 70	ft., and	in. to
WELL WATER TO BE USED AS:	5 Public water supply	8 Air conditioning	11 Injection well	
	1 Domestic	3 Feedlot	6 Oil field water supply	9 Dewatering
	2 Irrigation	4 Industrial	7 Lawn and garden only	10 Monitoring well
Was a chemical/bacteriological sample submitted to Department? Yes	No X	; If yes, mo/day/yr sample was submitted		
Water Well Disinfected? Yes X	No			

5 TYPE OF CASING USED:	5 Wrought iron	8 Concrete tile	CASING JOINTS:	Glued X Clamped
1 Steel	3 RMP (SR)	6 Asbestos-Cement	9 Other (Specify below)	Welded
2 PVC	4 ABS	7 Fiberglass	SDR-26	Threaded
Blank casing Diameter	5	in. to 25	ft., Dia	in. to
Casing height above land surface	12	in., weight	2.35	lbs. / ft. Wall thickness or gauge No. .214
TYPE OF SCREEN OR PERFORATION MATERIAL:	1 Steel	3 Stainless Steel	5 Fiberglass	7 PVC
	2 Brass	4 Galvanized steel	6 Concrete tile	8 RMP (SR)
SCREEN OR PERFORATION OPENING ARE:	5 Gauzed wrapped	8 Saw cut	11 None (open hole)	
1 Continuous slot	3 Mill slot	6 Wire wrapped	9 Drilled holes	
2 Louvered shutter	4 Key punched	7 Torch cut	10 Other (specify)	
SCREEN-PERFORATION INTERVALS:	from 25	ft. to 70	ft., From	ft. to
GRAVEL PACK INTERVALS:	from 24	ft. to 70	ft., From	ft. to

6 GROUT MATERIAL:	1 Neat cement	2 Cement grout	3 Bentonite	4 Other
Grout Intervals: From	4	ft. to 21	ft., From	ft. to
What is the nearest source of possible contamination:	1 Septic tank	4 Lateral lines	7 Pit privy	10 Livestock pens
	2 Sewer lines	5 Cess pool	8 Sewage lagoon	11 Fuel storage
	3 Watertight sewer lines	6 Seepage pit	9 Feedyard	12 Fertilizer storage
				13 Insecticide storage
				14 Abandon water well
				15 Oil well/Gas well
				16 Other (specify below)
				None Apparent

FROM	TO	LITHOLOGIC LOG	FROM	TO	PLUGGING INTERVALS
0	3	topsoil			
3	8	clay			
8	15	fine sand			
15	70	grey shale			

7 CONTRACTOR'S OR LANDOWNER'S CERTIFICATION: This water well was (1) constructed, (2) reconstructed, or (3) plugged under my jurisdiction and was completed on (mo/day/year) **09/21/1992** and this record is true to the best of my knowledge and belief. Kansas Water Well Contractor's License No. **236** This Water Well Record was completed on (mo/day/yr) **10/14/92** Under the business name of **Harp Well & Pump Service, Inc.** by (signature) *Jane Frederick*