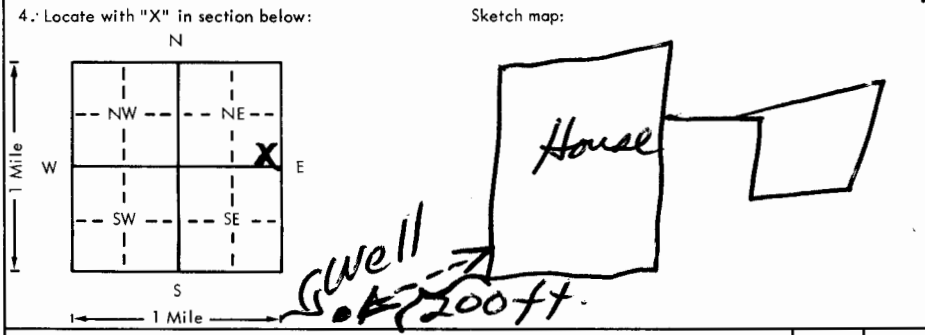


USE TYPEWRITER OR BALL POINT PEN-PRESS FIRMLY, PRINT CLEARLY.

WATER WELL RECORD  
KSA 82a-1201-1215

Kansas Department of Health and Environment-Division of Environment  
(Water well Contractors)  
Topeka, Kansas 66620

1. Location of well: County <b>Sumner</b> Fraction <b>SE 1/4 SE 1/4 NE 1/4</b> Section number <b>5</b> Township number <b>T 30 S</b> Range number <b>R 20 E</b>	
2. Distance and direction from nearest town or city: <b>1 mile E 1/4 So. Mulvane KS</b> Street address of well location if in city: _____	
3. Owner of well: <b>LARRY MYERS</b> R.R. or street: <b>1214 No. Westview</b> City, state, zip code: <b>Perby KS 67037</b>	
4. Locate with "X" in section below: Sketch map: 	
6. Bore hole dia. <b>1 1/2</b> in. Completion date <b>5/15/78</b> Well depth <b>40</b> ft.	
7. <input checked="" type="checkbox"/> Cable tool <input checked="" type="checkbox"/> Rotary <input type="checkbox"/> Driven <input type="checkbox"/> Dug <input type="checkbox"/> Hollow rod <input type="checkbox"/> Jetted <input type="checkbox"/> Bored <input type="checkbox"/> Reverse rotary	
8. Use: <input checked="" type="checkbox"/> Domestic <input type="checkbox"/> Public supply <input type="checkbox"/> Industry <input type="checkbox"/> Irrigation <input type="checkbox"/> Air conditioning <input type="checkbox"/> Stock <input type="checkbox"/> Lawn <input type="checkbox"/> Oil field water <input type="checkbox"/> Other	
5. Type and color of material	
10. Screen: Manufacturer's name <b>Santflower</b> Type <b>200</b> Dia. <b>5</b> in. Slot/auze <b>1/16</b> Length <b>38</b> Set between <b>12</b> ft. and <b>40</b> ft. Gravel pack? <b>Yes</b> Size range of material <b>3/8</b>	
11. Static water level: <b>12</b> ft. below land surface Date <b>5/15/78</b> mo./day/yr.	
12. Pumping level below land surfaces: <b>20</b> ft. after <b>1/2</b> hrs. pumping <b>15</b> g.p.m. _____ ft. after _____ hrs. pumping _____ g.p.m. Estimated maximum yield <b>15-20</b> g.p.m.	
13. Water sample submitted: _____ mo./day/yr. Yes <input checked="" type="checkbox"/> No <input type="checkbox"/> Date _____	
14. Well head completion: <input type="checkbox"/> Pitless adapter <b>12</b> Inches above grade	
15. Well grouted? <b>Yes</b> With: <input type="checkbox"/> Neat cement <input type="checkbox"/> Bentonite <input checked="" type="checkbox"/> Concrete Depth: From <b>3</b> ft. to <b>13</b> ft.	
16. Nearest source of possible contamination: <b>300 ft. NW Septic</b> Type _____ Well disinfected upon completion? <input checked="" type="checkbox"/> Yes <input type="checkbox"/> No	
17. Pump: <input checked="" type="checkbox"/> Not installed Manufacturer's name _____ Model number _____ HP _____ Volts _____ Length of drop pipe _____ ft. capacity _____ g.p.m. Type: <input type="checkbox"/> Submersible <input type="checkbox"/> Turbine <input type="checkbox"/> Jet <input type="checkbox"/> Reciprocating <input type="checkbox"/> Centrifugal <input type="checkbox"/> Other	
(Use a second sheet if needed)	
18. Elevation: _____ Topography: <input checked="" type="checkbox"/> Hill <input type="checkbox"/> Slope <input type="checkbox"/> Upland <input type="checkbox"/> Valley	19. Remarks: <b>Customer to furnish 4'x4'x4" slab around casing at grade per State Regulations</b> <b>Signed Larry J. Myers</b>
20. Water well contractor's certification: This well was drilled under my jurisdiction and this report is true to the best of my knowledge and belief. Business name <b>Wenger Dillen 318</b> Address <b>Colwich KS</b> Signed <b>Wenger</b> Date <b>5/15/78</b> Authorized representative	

T 30 S  
 R 20 E  
 Sec 5 SE SE NE  
 1/4 1/4 1/4

Forward the white, blue and pink copies to the Department of Health and Environment

Form WWC-5