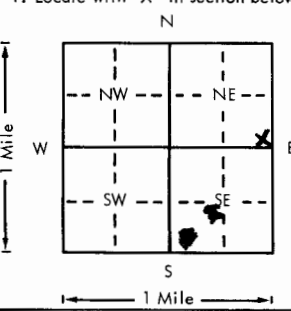
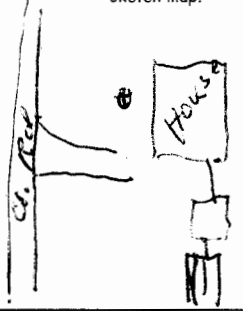


USE TYPEWRITER OR BALL POINT PEN-PRESS FIRMLY, PRINT CLEARLY.

WATER WELL RECORD
KSA 82a-1201-1215

Kansas Department of Health and Environment-Division of Environment (Water well Contractors) Topeka, Kansas 66620

1. Location of well:	County Sumner	Fraction SE 1/4 SE 1/4 NE 1/4	Section number 5	Township number T 30 S R 2 ①	Range number
2. Distance and direction from nearest town or city: Street address of well location if in city:			3. Owner of well: R.R. or street: City, state, zip code:		
4. Locate with "X" in section below: 			Sketch map: 		
5. Type and color of material			From	To	6. Bore hole dia. 3 3/4 in. Completion date 5-25-78 Well depth 45 ft.
TOP SOIL			0	3	7. <input checked="" type="checkbox"/> Cable tool <input checked="" type="checkbox"/> Rotary <input type="checkbox"/> Driven <input type="checkbox"/> Dug <input type="checkbox"/> Hollow rod <input type="checkbox"/> Jetted <input type="checkbox"/> Bored <input type="checkbox"/> Reverse rotary
SILT BROWN			3	15	8. Use: <input checked="" type="checkbox"/> Domestic <input type="checkbox"/> Public supply <input type="checkbox"/> Industry <input type="checkbox"/> Irrigation <input type="checkbox"/> Air conditioning <input type="checkbox"/> Stock <input type="checkbox"/> Lawn <input type="checkbox"/> Oil field water <input type="checkbox"/> Other
SHALE			15	45	9. Casing: Material PVC Height: Above or below Threaded <input type="checkbox"/> Welded <input type="checkbox"/> Surface 16 in. RMP PVC 64 Weight 16 lbs./ft. Dia. 5 in. to 35 ft. depth Wall thickness: inches or Dia. 5 in. to 35 ft. depth gage No. 258
					10. Screen: Manufacturer's name M. P. I. Type PVC Dia. 5 Slow gauze 25/1000 Length 10 Set between 35 ft. and 45 ft. ft. and 45 ft. Gravel pack? yes Size range of material 5/10
					11. Static water level: 18 ft. below land surface Date 5-25-78 mo./day/yr.
					12. Pumping level below land surfaces: ____ ft. after ____ hrs. pumping ____ g.p.m. ____ ft. after ____ hrs. pumping ____ g.p.m. Estimated maximum yield 20 g.p.m.
					13. Water sample submitted: ____ Yes <input checked="" type="checkbox"/> No Date 5-25-78 mo./day/yr.
					14. Well head completion: C.A.P. <input type="checkbox"/> Pitless adapter 16 Inches above grade
					15. Well grouted? yes With: <input checked="" type="checkbox"/> Neat cement <input type="checkbox"/> Bentonite <input type="checkbox"/> Concrete Depth: From 0 ft. to 10 ft.
					16. Nearest source of possible contamination: ft. 70 Direction NE Type septic Well disinfected upon completion? <input checked="" type="checkbox"/> Yes <input type="checkbox"/> No
					17. Pump: <input checked="" type="checkbox"/> Not installed Manufacturer's name _____ Model number _____ HP _____ Volts _____ Length of drop pipe _____ ft. capacity _____ g.p.m. Type: <input type="checkbox"/> Submersible <input type="checkbox"/> Turbine <input type="checkbox"/> Jet <input type="checkbox"/> Reciprocating <input type="checkbox"/> Centrifugal <input type="checkbox"/> Other
			(Use a second sheet if needed)		
18. Elevation: Topography: <input type="checkbox"/> Hill <input type="checkbox"/> Slope <input checked="" type="checkbox"/> Upland <input type="checkbox"/> Valley	19. Remarks:		20. Water well contractor's certification: This well was drilled under my jurisdiction and this report is true to the best of my knowledge and belief. PREVIT CONCT 353 Business name License No. Address BOX 744 Signed Archie Previt Date 5-25-78 Authorized representative		

30 20 5 SE SE NE