


MW-5

1 LOCATION OF WATER WELL: County: <u>Sumner</u>	Fraction <u>NE 1/4 NE 1/4 NE 1/4</u>	Section Number <u>6</u>	Township Number <u>T 30 S</u>	Range Number <u>R 2 E</u>
----------------------------------------------------	-----------------------------------------	----------------------------	----------------------------------	------------------------------

Distance and direction from nearest town or city street address of well if located within city?  
Northwest corner of intersection of 3rd & main, Mulvane

2 WATER WELL OWNER: Charles L Storey  
 RR#, St. Address, Box #: 30922 Sunnyside Drive  
 City, State, ZIP Code: Manhattan KS 66502  
 Board of Agriculture, Division of Water Resources  
 Application Number:

3 LOCATE WELL'S LOCATION WITH AN "X" IN SECTION BOX:  
 4 DEPTH OF COMPLETED WELL: 15.0 ft. ELEVATION: NA  
 Depth(s) Groundwater Encountered: 1 10.5 ft. 2. . . . . ft. 3. . . . . ft.  
 WELL'S STATIC WATER LEVEL: 8.21 ft. below land surface measured on mo/day/yr 6-10-92  
 Pump test data: Well water was . . . . . ft. after . . . . . hours pumping . . . . . gpm  
 Est. Yield . . . . . gpm Well water was . . . . . ft. after . . . . . hours pumping . . . . . gpm  
 Bore Hole Diameter: 8 in. to . . . . . ft., and . . . . . in. to . . . . . ft.  
 WELL WATER TO BE USED AS: 5 Public water supply 8 Air conditioning 11 Injection well  
 1 Domestic 3 Feedlot 6 Oil field water supply 9 Dewatering 12 Other (Specify below)  
 2 Irrigation 4 Industrial 7 Lawn and garden only 10 Monitoring well  
 Was a chemical/bacteriological sample submitted to Department? Yes . . . . . No X . . . . . If yes, mo/day/yr sample was submitted  
 Water Well Disinfected? Yes . . . . . No X

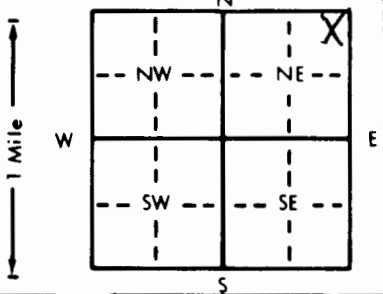

5 TYPE OF BLANK CASING USED:  
 1 PVC 3 RMP (SR) 5 Wrought iron 8 Concrete tile CASING JOINTS: Glued . . . . . Clamped . . . . .  
 2 PVC 4 ABS 6 Asbestos-Cement 9 Other (specify below) Welded . . . . .  
 Blank casing diameter: 2 in. to . . . . . ft., Dia . . . . . in. to . . . . . ft., Dia . . . . . in. to . . . . . ft.  
 Casing height above land surface: Flush in., weight . . . . . 70.3 lbs./ft. Wall thickness or gauge No. . . . . 154  
 TYPE OF SCREEN OR PERFORATION MATERIAL:  
 1 Steel 3 Stainless steel 5 Fiberglass 8 RMP (SR) 10 Asbestos-cement  
 2 Brass 4 Galvanized steel 6 Concrete tile 9 ABS 11 Other (specify) . . . . .  
 SCREEN OR PERFORATION OPENINGS ARE:  
 1 Continuous slot 3 Mill slot 5 Gauzed wrapped 8 Saw cut 11 None (open hole)  
 2 Louvered shutter 4 Key punched 6 Wire wrapped 9 Drilled holes  
 SCREEN-PERFORATED INTERVALS: From . . . . . 4.85 ft. to . . . . . 14.85 ft., From . . . . . ft. to . . . . . ft.  
 GRAVEL PACK INTERVALS: From . . . . . 3.85 ft. to . . . . . 14.85 ft., From . . . . . ft. to . . . . . ft.

6 GROUT MATERIAL: 1 Neat cement 2 Cement grout 3 Bentonite 4 Other . . . . .  
 Grout Intervals: From . . . . . 3.85 ft. to . . . . . 1.0 ft., From . . . . . ft. to . . . . . ft., From . . . . . ft. to . . . . . ft.  
 What is the nearest source of possible contamination:  
 1 Septic tank 4 Lateral lines 7 Pit privy 10 Livestock pens 14 Abandoned water well  
 2 Sewer lines 5 Cess pool 8 Sewage lagoon 11 Fuel storage 15 Oil well/Gas well  
 3 Watertight sewer lines 6 Seepage pit 9 Feedyard 12 Fertilizer storage 16 Other (specify below)  
 13 Insecticide storage  
 Direction from well? Northwest How many feet? ~180

FROM	TO	LITHOLOGIC LOG	FROM	TO	PLUGGING INTERVALS
0.0	0.5	Silty Clay topsoil			
0.5	6.0	Rubble, concrete, fill dirt			
6.0	11.5	Sand, fine to medium grained well sorted, silty			
11.5	15.0	Clay soft, plastic, silty slightly sandy, fine grained, well sorted			
Flush mount waiver granted for Storey Oil Co, mulvane, KS on 4-21-92 by Don Taylor					

7 CONTRACTOR'S OR LANDOWNER'S CERTIFICATION: This water well was (1) constructed, (2) reconstructed, or (3) plugged under my jurisdiction and was completed on (mo/day/year) . . . . . 5-19-92 . . . . . and this record is true to the best of my knowledge and belief. Kansas Water Well Contractor's License No. . . . . 531 . . . . . This Water Well Record was completed on (mo/day/yr) . . . . . 6-11-92 . . . . . under the business name of Geotechnical Services, Inc by (signature) Allison Irwin