


1 LOCATION OF WATER WELL: County: Sumner Fraction: SW 1/4 SW 1/4 SE 1/4 Section Number: 15 Township Number: T 30 S Range Number: R 2 E  
 Distance and direction from nearest town or city street address of well if located within city? 2 E 350 1/2 E of Mulvane

2 WATER WELL OWNER: Carl Storey RR#, St. Address, Box #: R1 City, State, ZIP Code: Mulvane 67110  
 Board of Agriculture, Division of Water Resources Application Number:

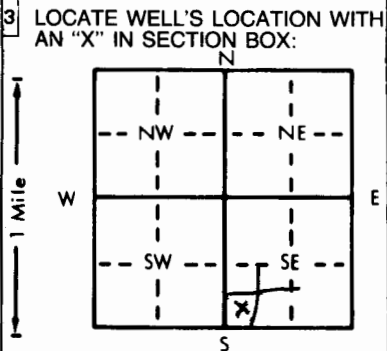

4 DEPTH OF COMPLETED WELL: 72 ft. ELEVATION: Slope  
 Depth(s) Groundwater Encountered: 1 53 ft. 2. . . . . ft. 3. . . . . ft.  
 WELL'S STATIC WATER LEVEL: 3 ft. below land surface measured on mo/day/yr 4-18-84  
 Pump test data: Well water was . . . . . ft. after . . . . . hours pumping . . . . . gpm  
 Est. Yield . . . . . gpm: Well water was . . . . . ft. after . . . . . hours pumping . . . . . gpm  
 Bore Hole Diameter: 8 in. to 72 ft., and . . . . . in. to . . . . . ft.  
 WELL WATER TO BE USED AS:  
 Domestic    3 Feedlot    6 Oil field water supply    9 Dewatering    12 Other (Specify below)  
 Irrigation    4 Industrial    7 Lawn and garden only    10 Observation well  
 Was a chemical/bacteriological sample submitted to Department? Yes . . . . . No ; If yes, mo/day/yr sample was submitted  
 Water Well Disinfected? Yes  No

5 TYPE OF BLANK CASING USED:  
 1 Steel    3 RMP (SR)    5 Wrought iron    8 Concrete tile    CASING JOINTS: Glued  Clamped . . . . .  
 PVC    4 ABS    6 Asbestos-Cement    9 Other (specify below)    Welded . . . . .  
 7 Fiberglass    Threaded . . . . .  
 Blank casing diameter: 5.0 in. to 52 ft., Dia . . . . . in. to . . . . . ft., Dia . . . . . in. to . . . . . ft.  
 Casing height above land surface: 14 in., weight . . . . . lbs./ft. Wall thickness or gauge No. 160 16  
 TYPE OF SCREEN OR PERFORATION MATERIAL:  
 PVC    10 Asbestos-cement  
 1 Steel    3 Stainless steel    5 Fiberglass    8 RMP (SR)    11 Other (specify) . . . . .  
 2 Brass    4 Galvanized steel    6 Concrete tile    9 ABS    12 None used (open hole)  
 SCREEN OR PERFORATION OPENINGS ARE:  
 1 Continuous slot    3 Mill slot    5 Gauzed wrapped     Saw cut    11 None (open hole)  
 2 Louvered shutter    4 Key punched    6 Wire wrapped    9 Drilled holes  
 7 Torch cut    10 Other (specify) . . . . .  
 SCREEN-PERFORATED INTERVALS: From 52 ft. to 72 ft., From . . . . . ft. to . . . . . ft.  
 From . . . . . ft. to . . . . . ft., From . . . . . ft. to . . . . . ft.  
 GRAVEL PACK INTERVALS: From 72 ft. to 10 ft., From . . . . . ft. to . . . . . ft.  
 From . . . . . ft. to . . . . . ft., From . . . . . ft. to . . . . . ft.

6 GROUT MATERIAL: 1 Neat cement     Cement grout    3 Bentonite    4 Other . . . . .  
 Grout Intervals: From 10 ft. to 0 ft., From . . . . . ft. to . . . . . ft., From . . . . . ft. to . . . . . ft.  
 What is the nearest source of possible contamination: open field  
 1 Septic tank    4 Lateral lines    7 Pit privy    10 Livestock pens    14 Abandoned water well  
 2 Sewer lines    5 Cess pool    8 Sewage lagoon    11 Fuel storage    15 Oil well/Gas well  
 3 Watertight sewer lines    6 Seepage pit    9 Feedyard    12 Fertilizer storage    16 Other (specify below)  
 13 Insecticide storage . . . . .  
 Direction from well? How many feet?

FROM	TO	LITHOLOGIC LOG	FROM	TO	LITHOLOGIC LOG
0	1	Top Soil			
1	4	Clay silty Black			
4	18	Clay yellow Red with sand			
18	24	Shale Rusty Red			
24	53	Shale yellow gray			
53	72	Shale gray			

7 CONTRACTOR'S OR LANDOWNER'S CERTIFICATION: This water well was  constructed, (2) reconstructed, or (3) plugged under my jurisdiction and was completed on (mo/day/year) 4-18-84 and this record is true to the best of my knowledge and belief. Kansas Water Well Contractor's License No. 363 This Water Well Record was completed on (mo/day/yr) 4-18-84 under the business name of Braddy Water Wells by (signature) Richard Braddy

INSTRUCTIONS: Use typewriter or ball point pen, PLEASE PRESS FIRMLY and PRINT clearly. Please fill in blanks, underline or circle the correct answers. Send top three copies to Kansas Department of Health and Environment, Division of Environment, Environmental Geology Section, Topeka, KS 66620. Send one to WATER WELL OWNER and retain one for your records.