


1 LOCATION OF WATER WELL: County: Sumner Fraction: NW 1/4 NW 1/4 NE 1/4 Section Number: 35 Township Number: T 30 S Range Number: R 2 E

Distance and direction from nearest town or city street address of well if located within city? 3 Mile West 1/4 N of Udal Grete

2 WATER WELL OWNER: Lynn Thompson RR#, St. Address, Box #: RR1 Box 101 Udal Kan City, State, ZIP Code: 67146 Board of Agriculture, Division of Water Resources Application Number:

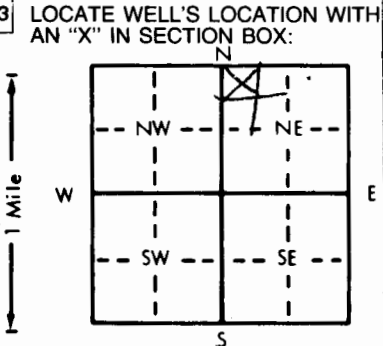

4 DEPTH OF COMPLETED WELL: 95 ft. ELEVATION: 8-1-83 ft.
 Depth(s) Groundwater Encountered: 1. 83 ft. 2. 83 ft. 3. 83 ft.
 WELL'S STATIC WATER LEVEL: 30 ft. below land surface measured on mo/day/yr 8-1-83
 Pump test data: Well water was _____ ft. after _____ hours pumping _____ gpm
 Est. Yield: 70 gpm Well water was _____ ft. after _____ hours pumping _____ gpm
 Bore Hole Diameter: 8 1/2 in. to 9.5 in. and _____ in. to _____ in.
 WELL WATER TO BE USED AS:
 1 Domestic 2 Irrigation 3 Feedlot 4 Industrial 5 Public water supply 6 Oil field water supply 7 Lawn and garden only 8 Air conditioning 9 Dewatering 10 Observation well 11 Injection well 12 Other (Specify below)
 Was a chemical/bacteriological sample submitted to Department? Yes _____ No (No); If yes, mo/day/yr sample was submitted _____
 Water Well Disinfected? (Yes) No

5 TYPE OF BLANK CASING USED:
 1 Steel 2 PVC 3 RMP (SR) 4 ABS 5 Wrought iron 6 Asbestos-Cement 7 Fiberglass 8 Concrete tile 9 Other (specify below) 10 Asbestos-cement 11 Other (specify) 12 None used (open hole)
 Blank casing diameter: 5 in. to 50 ft., Dia. _____ in. to _____ ft., Dia. _____ in. to _____ ft., Dia. _____ in. to _____ ft.
 Casing height above land surface: 18 in., weight _____ lbs./ft. Wall thickness or gauge No. 214
 TYPE OF SCREEN OR PERFORATION MATERIAL:
 1 Steel 2 Brass 3 Stainless steel 4 Galvanized steel 5 Fiberglass 6 Concrete tile 7 PVC 8 RMP (SR) 9 ABS 10 Asbestos-cement 11 Other (specify) 12 None used (open hole)
 SCREEN OR PERFORATION OPENINGS ARE:
 1 Continuous slot 2 Louvered shutter 3 Mill slot 4 Key punched 5 Gauzed wrapped 6 Wire wrapped 7 Torch cut 8 Saw cut 9 Drilled holes 10 Other (specify) 11 None (open hole)
 SCREEN-PERFORATED INTERVALS: From 70 ft. to 95 ft., From _____ ft. to _____ ft., From _____ ft. to _____ ft., From _____ ft. to _____ ft.
 GRAVEL PACK INTERVALS: From 50 ft. to 95 ft., From _____ ft. to _____ ft., From _____ ft. to _____ ft., From _____ ft. to _____ ft.

6 GROUT MATERIAL: 1 Neat cement 2 Cement grout 3 Bentonite 4 Other 50-13ft?
 Grout Intervals: From 0 ft. to 13 ft., From _____ ft. to _____ ft., From _____ ft. to _____ ft., From _____ ft. to _____ ft.
 What is the nearest source of possible contamination:
 1 Septic tank 2 Sewer lines 3 Watertight sewer lines 4 Lateral lines 5 Cess pool 6 Seepage pit 7 Pit privy 8 Sewage lagoon 9 Feedyard 10 Livestock pens 11 Fuel storage 12 Fertilizer storage 13 Insecticide storage 14 Abandoned water well 15 Oil well/Gas well 16 Other (specify below)
 Direction from well? North How many feet? 75

FROM	TO	LITHOLOGIC LOG	FROM	TO	LITHOLOGIC LOG
0	3	Soil Sandy Clay sand shale Lime			
3	15				
15	30				
30	60				
60	95				

7 CONTRACTOR'S OR LANDOWNER'S CERTIFICATION: This water well was (1) constructed, (2) reconstructed, or (3) plugged under my jurisdiction and was completed on (mo/day/year) 8-1-83 and this record is true to the best of my knowledge and belief. Kansas Water Well Contractor's License No. 251 This Water Well Record was completed on (mo/day/yr) 10/13/83 under the business name of Winter Well Drill by (signature) Charles Winter
 INSTRUCTIONS: Use typewriter or ball point pen, PLEASE PRESS FIRMLY and PRINT clearly. Please fill in blanks, underline or circle the correct answers. Send top three copies to Kansas Department of Health and Environment, Division of Environment, Environmental Geology Section, Topeka, KS 66620. Send one to WATER WELL OWNER and retain one for your records.