


1 LOCATION OF WATER WELL: **Sumner** FRACTION **NW 1/4 NE 1/4 SW 1/4** Section Number **5** Township Number **T 30 S** Range Number **R 2E E/W**

Distance and direction from nearest town or city street address of well if located within city?
602 S. Central Mulvane, Kansas

2 WATER WELL OWNER: **MAYO, Macy** Board of Agriculture, Divivson of Water Resource
 RR#, ST. ADDRESS, BOX #: **602 S. Central**
 CITY, STATE, ZIP CODE: **Mulvane, Kansas** Application Number:

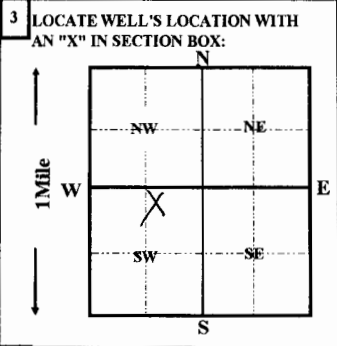

4 DEPTH OF COMPLETED WELL **55** ft. ELEVATION:
 Depth(s) groundwater Encountered **1** ft. **2** ft. **3** ft. ft.
 WELL'S STATIC WATER LEVEL **26** FT. BELOW LAND SURFACE MEASURED ON **08/04/1994**
 Pump test data: Well water was ft. after hours pumping gpm
 Est. Yield gpm: Well water was ft. after hours pumping gpm
 Bore Hole Diameter **12** in. to **55** ft. and in. to ft.
 WELL WATER TO BE USED AS: **5** Public water supply **8** Air conditioning **11** Injection well
1 Domestic **3** Feedlot **6** Oil field water supply **9** Dewatering **12** Other (Specify below)
2 Irrigation **4** Industrial **7** Lawn and garden only **10** Monitoring well
 Was a chemical/bacteriological sample submitted to Department? Yes No **X** ; If yes, mo/day/yr sample was submitted Water Well Disinfected? Yes **X** No

5 TYPE OF CASING USED: **5** Wrought iron **8** Concrete tile CASING JOINTS: **X** Glued **X** Clamped
1 Steel **3** RMP (SR) **6** Asbestos-Cement **9** Other (Specify below) **10** Asbestos-cement Welded
2 PVC **4** ABS **7** Fiberglass **SDR-26** Threaded
 Blank casing Diameter **5** in. to **25** ft., Dia in. to ft., Dia in. to ft.
 Casing height above land surface **12** in., weight **2.35** lbs. / ft. Wall thickness or gauge No. **.214**
 TYPE OF SCREEN OR PERFORATION MATERIAL: **7** PVC **10** Asbestos-cement
1 Steel **3** Stainless Steel **5** Fiberglass **8** RMP (SR) **11** other (specify)
2 Brass **4** Galvanized steel **6** Concrete tile **9** ABS **12** None used (open hole)
 SCREEN OR PERFORATION OPENING ARE: **5** Gauzed wrapped **8** Saw cut **11** None (open hole)
1 Continous slot **3** Mill slot **6** Wire wrapped **9** Drilled holes
2 Louvered shutter **4** Key punched **7** Torch cut **10** Other (specify)
 SCREEN-PERFORATION INTERVALS: from **25** ft. to **55** ft., From ft. to ft.
 GRAVEL PACK INTERVALS: from **24** ft. to **55** ft., From ft. to ft.

6 GROUT MATERIAL: **1** Neat cement **2** Cement grout **3** Bentonite **4** Other
 Grout Intervals: From **4** ft. to **24** ft. From ft. to ft. From ft. to ft.
 What is the nearest source of possible contamination:
1 Septic tank **4** Lateral lines **7** Pit privy **10** Livestock pens **14** Abandon water well
2 Sewer lines **5** Cess pool **8** Sewage lagoon **11** Fuel storage **15** Oil well/Gas well
3 Watertight sewer lines **6** Seepage pit **9** Feedyard **12** Fertilizer storage **16** Other (specify below)
13 Insecticide storage

Direction from well? **Northeast** How many feet? **15**

FROM	TO	LITHOLOGIC LOG	FROM	TO	PLUGGING INTERVALS
0	3	topsoil			
3	22	clay			
22	30	medium sand			
30	55	grey shale			

7 CONTRACTOR'S OR LANDOWNER'S CERTIFICATION: This water well was (1) constructed, (2) reconstructed, or (3) plugged under my jurisdiction and was completed on (mo/day/year) **08/04/1994** and this record is true to the best of my knowledge and belief. Kansas Water Well Contractor's License No. **236** This Water Well Record was completed on (mo/day/yr) **08/06/94**
 Under the business name of **Harp Well & Pump Service, Inc** by (signature) *Jane Frederick*