WATER WELL RECORD Form WWC-5 KSA 82a-1212

1 LOCATION OF WATER WELL: County: CRAWFORD	Fraction ¼ ¼ NW ¼	Section Number 27	Township Number T 30 S	Range Number R 23 E/W

Distance and direction from nearest town or city street address of well if located within city?

2 WATER WELL OWNER: DENVER LAWSON
RR#, St. Address, Box # : 367 West 126 Hwy
City, State, ZIP Code : Pittsburg, Ks 66762

Board of Agriculture, Division of Water Resources Application Number:

3 LOCATE WELL'S LOCATION WITH AN "X" IN SECTION BOX:

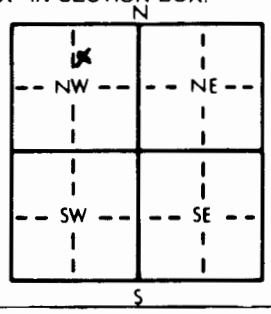

4 DEPTH OF COMPLETED WELL 682 ft. ELEVATION:
Depth(s) Groundwater Encountered 1. 637 ft. 2. ft. 3. ft.
WELL'S STATIC WATER LEVEL 225 ft. below land surface measured on mo/day/yr 6-23-96
Pump test data: Well water was ft. after hours pumping gpm
Est. Yield 10 gpm: Well water was ft. after hours pumping gpm
Bore Hole Diameter 10 in. to 485.6 ft., and 6 1/8 in. to ft.
WELL WATER TO BE USED AS: 5 Public water supply 8 Air conditioning 11 Injection well
1 Domestic 3 Feedlot 6 Oil field water supply 9 Dewatering 12 Other (Specify below)
2 Irrigation (4 Industrial) 7 Lawn and garden only 10 Monitoring well
Was a chemical/bacteriological sample submitted to Department? Yes (No); If yes, mo/day/yr sample was submitted
Water Well Disinfected? (Yes) No

5 TYPE OF BLANK CASING USED: 5 Wrought iron 8 Concrete tile CASING JOINTS: Glued Clamped
(1 Steel) 3 RMP (SR) 6 Asbestos-Cement 9 Other (specify below) (Welded)
2 PVC 4 ABS 7 Fiberglass Threaded
Blank casing diameter 6 5/8 in. to 487 ft., Dia in. to ft., Dia in. to ft.
Casing height above land surface 20 in., weight 13 lbs./ft. Wall thickness or gauge No. 188
TYPE OF SCREEN OR PERFORATION MATERIAL: 7 PVC 10 Asbestos-cement
1 Steel 3 Stainless steel 5 Fiberglass 8 RMP (SR) 11 Other (specify)
2 Brass 4 Galvanized steel 6 Concrete tile 9 ABS 12 None used (open hole)
SCREEN OR PERFORATION OPENINGS ARE: 5 Gauzed wrapped 8 Saw cut 11 None (open hole)
1 Continuous slot 3 Mill slot 6 Wire wrapped 9 Drilled holes
2 Louvered shutter 4 Key punched 7 Torch cut 10 Other (specify)
SCREEN-PERFORATED INTERVALS: From ft. to ft., From ft. to ft.
From ft. to ft., From ft. to ft.
GRAVEL PACK INTERVALS: From ft. to ft., From ft. to ft.
From ft. to ft., From ft. to ft.

6 GROUT MATERIAL: 1 Neat cement 2 Cement grout (3 Bentonite) 4 Other
Grout Intervals: From 485 ft. to 430 ft., From ft. to ft., From ft. to ft.
What is the nearest source of possible contamination: 10 Livestock pens 14 Abandoned water well
1 Septic tank 4 Lateral lines 7 Pit privy 11 Fuel storage 15 Oil well/Gas well
2 Sewer lines 5 Cess pool 8 Sewage lagoon 12 Fertilizer storage 16 Other (specify below)
3 Watertight sewer lines 6 Seepage pit 9 Feedyard 13 Insecticide storage Turkey house
Direction from well? How many feet? 100'

FROM	TO	LITHOLOGIC LOG	FROM	TO	PLUGGING INTERVALS
0	14	Top soil + overburden			
14	429	Shale + Lime stone			
429	682	solid Lime stone			

7 CONTRACTOR'S OR LANDOWNER'S CERTIFICATION: This water well was (1) (constructed), (2) reconstructed, or (3) plugged under my jurisdiction and was completed on (mo/day/year) 5-23-96 and this record is true to the best of my knowledge and belief. Kansas Water Well Contractor's License No. 492-A This Water Well Record was completed on (mo/day/yr)
under the business name of TICHENOR DRILLING INC by (signature) Jean Tichenor

INSTRUCTIONS: Use typewriter or ball point pen. *PLEASE PRESS FIRMLY* and *PRINT* clearly. Please fill in blanks, underline or circle the correct answers. Send top three copies to Kansas Department of Health and Environment, Bureau of Water, Topeka, Kansas 66620-0001. Telephone: 913-296-5545. Send one to WATER WELL OWNER and retain one for your records.

OFFICE USE ONLY T R E/W SEC. ¼ ¼ ¼