

WATER WELL RECORD MW-1

Form WWC-5

Division of Water Resources: App. No.

1 LOCATION OF WATER WELL: County: Crawford Fraction: NE 1/4 NE 1/4 1/4 Section Number: 25 Township Number: T 30 S Range Number: R 24 E/W

2 WATER WELL OWNER: Tyrell's Service and Store RR#, St. Address, Box #: 1117 W. Fourth Street City, State, ZIP Code: Pittsburg, KS

3 LOCATE WELL'S LOCATION WITH AN 'X' IN SECTION BOX: [Diagram showing a 3x3 grid with 'X' in the top-middle cell] 4 DEPTH OF COMPLETED WELL: 13.75 ft.


5 TYPE OF CASING USED: 1 Steel, 2 PVC, 3 RMP (SR), 4 ABS, 5 Wrought Iron, 6 Asbestos-Cement, 7 Fiberglass, 8 Concrete tile, 9 Other (specify below), 10 Asbestos-Cement, 11 Injection well, 12 Other (Specify below), 13 Dewatering, 14 Monitoring well

6 GROUT MATERIAL: 1 Neat cement, 2 Cement grout, 3 Bentonite, 4 Other. Grout Intervals: From 1 ft. to 2.75 ft.


Table with columns: FROM, TO, LITHOLOGIC LOG, FROM, TO, PLUGGING INTERVALS. Rows include lithological descriptions like 'brown clay', 'Dark brown clay', 'Light brown silty shale', 'Refusal Sandstone'.

7 CONTRACTOR'S OR LANDOWNER'S CERTIFICATION: This water well was (1) constructed, (2) reconstructed, or (3) plugged under my jurisdiction and was completed on (mo/day/year) 11-2-07.

INSTRUCTIONS: Use typewriter or ball point pen. PLEASE PRESS FIRMLY and PRINT clearly. Please fill in blanks, underline or circle the correct answers.

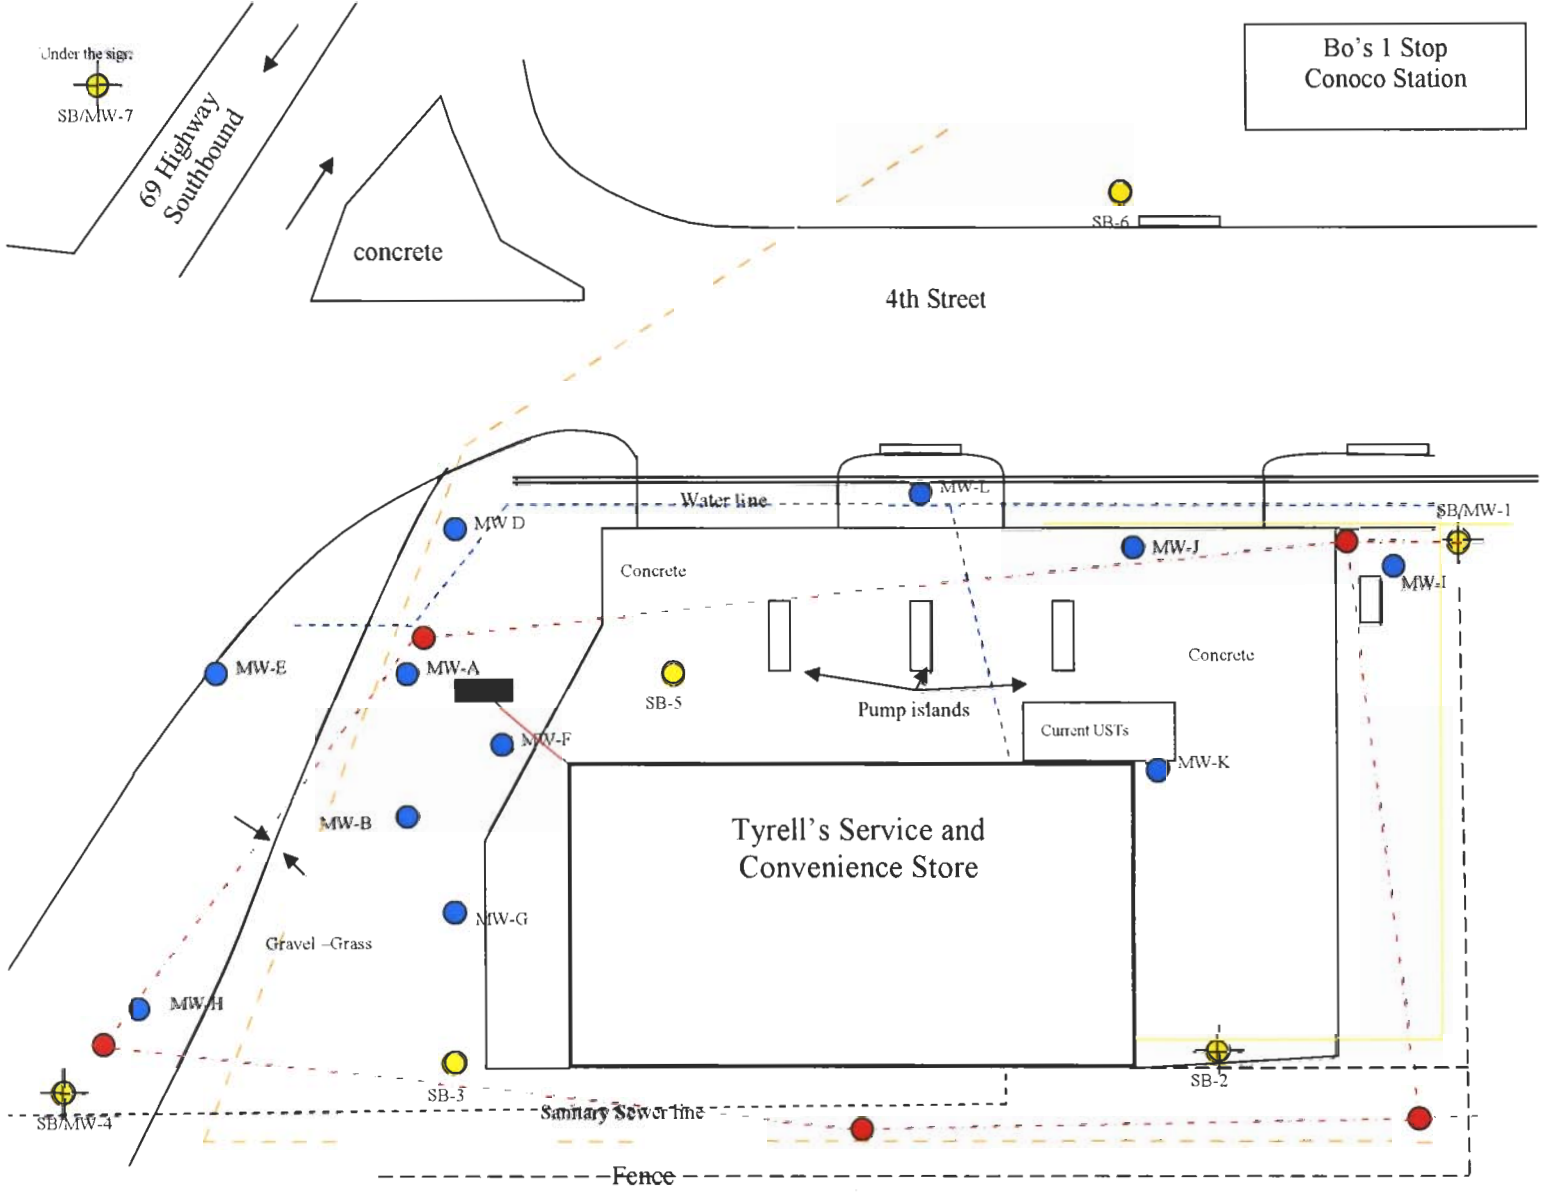

- Existing wells
- ⊕ New well locations
- New boring locations
- - - Overhead power lines  
Telecomm/Fiberoptic line
- Buried gas line
- - - Buried water line
- ▭ Storm sewer drain
- ▭ Site sign and buried electric line

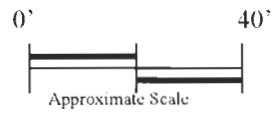

**Boring/Well Location Map**  
 Tyrell's Service and Store  
 117 W. Fourth Street  
 Pittsburg, KS

**Figure 3**  
 Apex # ERA03.003