

<b>1 LOCATION OF WATER WELL:</b> County: <u>Crawford</u>	Fraction <u>1/4 NE 1/4 NE 1/4</u>	Section Number <u>25</u>	Township Number T <u>30S</u>	Range Number R <u>24</u> <u>EW</u>
---	--------------------------------------	-----------------------------	---------------------------------	---------------------------------------

Distance and direction from nearest town or city street address of well if located within city? **Global Positioning Systems** (decimal degrees, min. of 4 digits)  
 Latitude: \_\_\_\_\_  
 Longitude: \_\_\_\_\_  
 Elevation: \_\_\_\_\_  
 Datum: \_\_\_\_\_

**2 WATER WELL OWNER:** Tyreil's Service and Store  
 RR#, St. Address, Box # 117 W. fourth street  
 City, State, ZIP Code Pittsburg KS  
 Data Collection Method: \_\_\_\_\_

**3 LOCATE WELL'S LOCATION WITH AN "X" IN SECTION BOX:**

N					
		X			
	NW	NE			
	SW	SE			
S					

**4 DEPTH OF COMPLETED WELL** ..... 13.5 ft.

Depth(s) Groundwater Encountered (1) ..... ft. (2) ..... ft. (3) ..... ft.  
 WELL'S STATIC WATER LEVEL ..... 5.0 ft. below land surface measured on mo/day/yr. 11-14-07  
 Pump test data: Well water was ..... ft. after ..... hours pumping ..... gpm  
 Est. Yield ..... gpm: Well water was ..... ft. after ..... hours pumping ..... gpm  
 WELL WATER TO BE USED AS: 5 Public water supply 8 Air conditioning 11 Injection well  
 1 Domestic 3 Feedlot 6 Oil field water supply 9 Dewatering 12 Other (Specify below)  
 2 Irrigation 4 Industrial 7 Domestic (lawn & garden) 10 Monitoring well

Was a chemical/bacteriological sample submitted to Department? Yes ..... No X; If yes, mo/day/yr  
 Sample was submitted N/A Water well disinfected? Yes ..... No X

**5 TYPE OF CASING USED:**

1 Steel	3 RMP (SR)	6 Asbestos-Cement	9 Other (specify below)	CASING JOINTS: Glued ..... Clamped .....
2 PVC	4 ABS	7 Fiberglass		Welded .....
				<u>Threaded</u> .....

Blank casing diameter ..... 2 in. to ..... 3.5 ft., Diameter ..... in. to ..... ft., Diameter ..... in. to ..... ft.  
 Casing height above land surface ..... 0 in., Weight ..... lbs./ft. Wall thickness or gauge No. 5.1 70

TYPE OF SCREEN OR PERFORATION MATERIAL:

1 Steel	3 Stainless Steel	5 Fiberglass	<u>7 PVC</u>	9 ABS	11 Other (Specify) .....
2 Brass	4 Galvanized Steel	6 Concrete tile	8 RM (SR)	10 Asbestos-Cement	12 None used (open hole)

SCREEN OR PERFORATION OPENINGS ARE:

1 Continuous slot	<u>3 Mill slot</u>	5 Gauzed wrapped	7 Torch cut	9 Drilled holes	11 None (open hole)
2 Louvered shutter	4 Key punched	6 Wire wrapped	8 Saw Cut	10 Other (specify) .....	

SCREEN-PERFORATED INTERVALS: From ..... 3.5 ft. to ..... 13.5 ft., From ..... ft. to ..... ft.  
 From ..... ft. to ..... ft., From ..... ft. to ..... ft.

GRAVEL PACK INTERVALS: From ..... 2.5 ft. to ..... 13.5 ft., From ..... ft. to ..... ft.  
 From ..... ft. to ..... ft., From ..... ft. to ..... ft.

**6 GROUT MATERIAL:** 1 Neat cement 2 Cement grout 3 Bentonite 4 Other .....

Grout Intervals: From ..... 1 ft. to ..... 2.5 ft., From ..... ft. to ..... ft., From ..... ft. to ..... ft.

What is the nearest source of possible contamination:


1 Septic tank	4 Lateral lines	7 Pit privy	<u>10 Livestock pens</u>	13 Insecticide Storage	16 Other (specify below)
2 Sewer lines	5 Cess pool	8 Sewage lagoon	<u>11 Fuel storage</u>	14 Abandoned water well	
3 Watertight sewer lines	6 Seepage pit	9 Feedyard	12 Fertilizer Storage	15 Oil well/gas well	

Direction from well? ..... How many feet? .....


FROM	TO	LITHOLOGIC LOG	FROM	TO	PLUGGING INTERVALS
0	6"	Grass			
6"	6'	Tight dark brown clay			
6'	10'	Brown clay - staining			
10'	13'	Brown mottled clay			
13.5'		Light brown sticky shale			

**7 CONTRACTOR'S OR LANDOWNER'S CERTIFICATION:** This water well was (1) constructed, (2) reconstructed, or (3) plugged under my jurisdiction and was completed on (mo/day/year) 11-2-07 and this record is true to the best of my knowledge and belief. Kansas Water Well Contractor's License No. 759 This Water Well Record was completed on (mo/day/year) 11-11-07 under the business name of RAZEK Environmental LLC by (signature) Linch D. Banta

**INSTRUCTIONS:** Use typewriter or ball point pen. PLEASE PRESS FIRMLY and PRINT clearly. Please fill in blanks, underline or circle the correct answers. Send top three copies to Kansas Department of Health and Environment, Bureau of Water, Geology Section, 1000 SW Jackson St., Suite 420, Topeka, Kansas 66612-1367. Telephone 785-296-5522. Send one to WATER WELL OWNER and retain one for your records. Fee of \$5.00 for each constructed well. Visit us at <http://www.kdheks.gov/waterwell/index.html>.

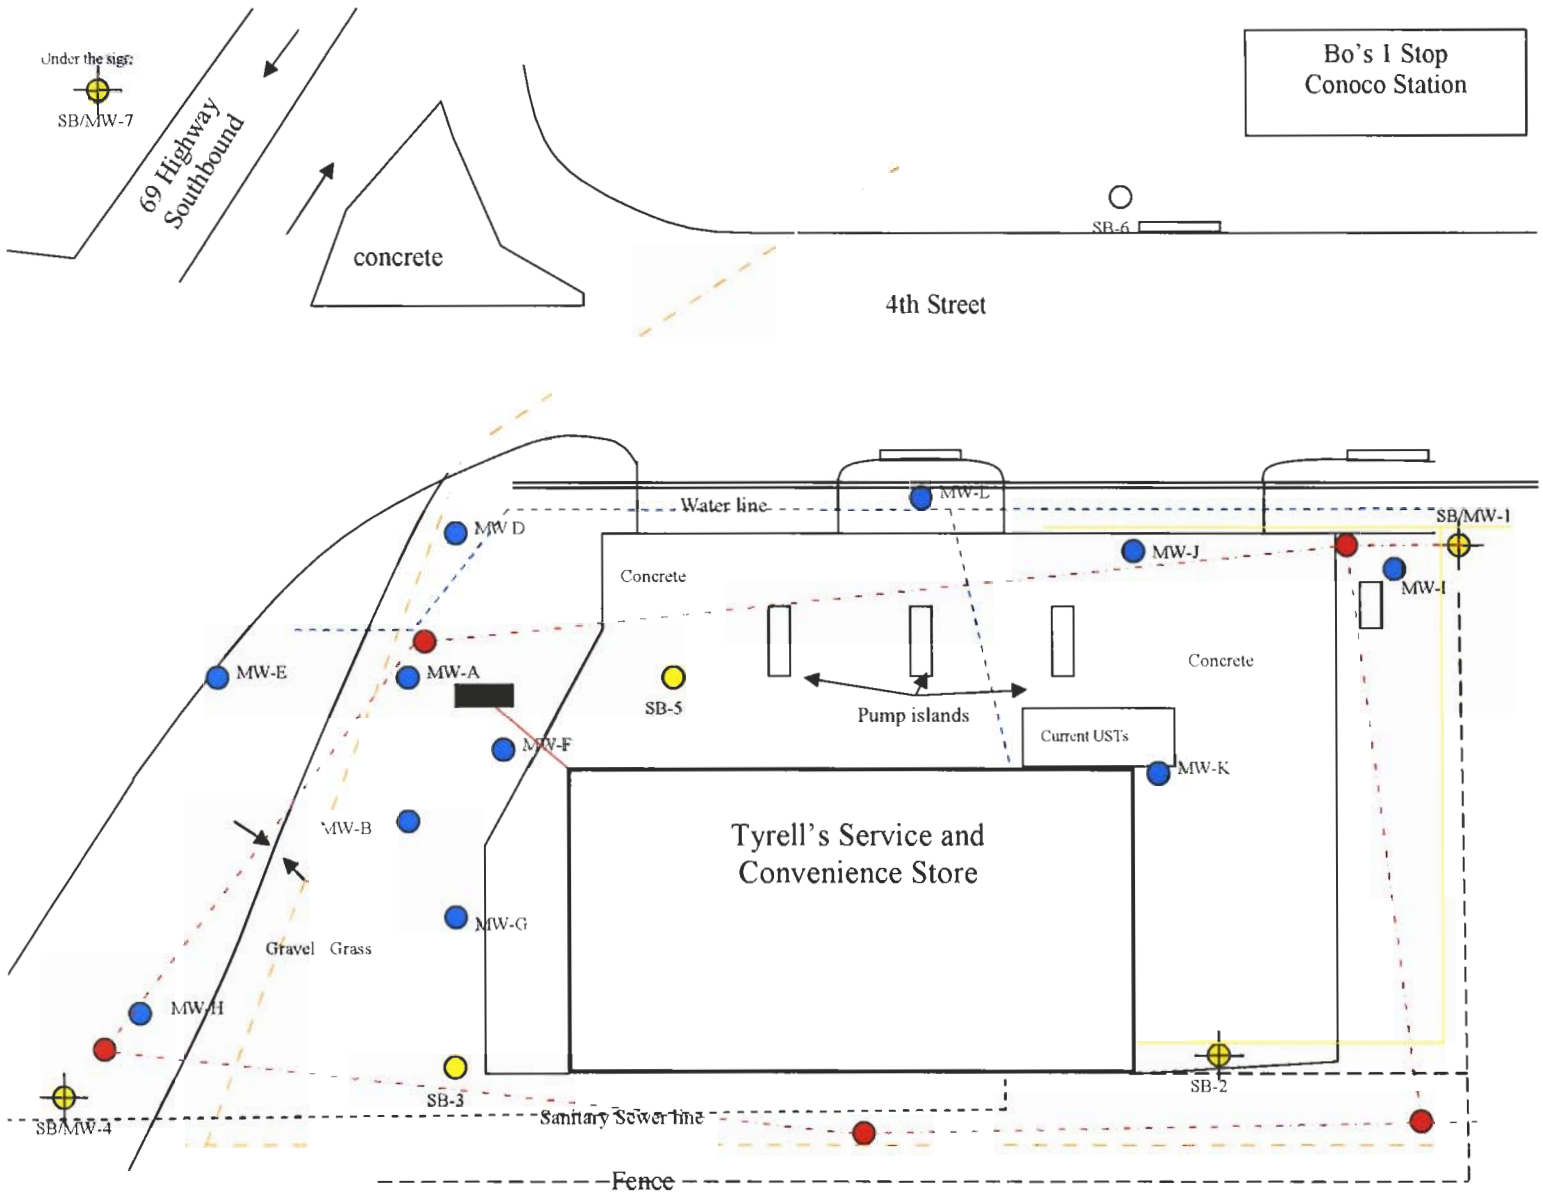

- Existing wells
- ⊕ New well locations
- New boring locations
- Overhead power lines
- Telecomm/Fiberoptic line
- Buried gas line
- Buried water line
- Storm sewer drain
- Site sign and buried electric line

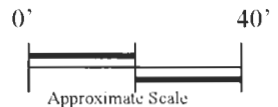

**Boring/Well Location Map**  
Tyrell's Service and Store  
117 W. Fourth Street  
Pittsburg, KS

**Figure 3**  
Apex # ERA03.003