


1 LOCATION OF WATER WELL: County: Crawford Fraction: 1/4 NE 1/4 NE 1/4 Section Number: 25 Township Number: T 30 S Range Number: R 24 E/W

Distance and direction from nearest town or city street address of well if located within city? _____ **Global Positioning Systems** (decimal degrees, min. of 4 digits)
 Latitude: _____
 Longitude: _____
 Elevation: _____
 Datum: _____
 Data Collection Method: _____

2 WATER WELL OWNER: Tyrell's Service and Store
 RR#, St. Address, Box # : 117 W. Fourth Street
 City, State, ZIP Code : Pittsburg, KS

3 LOCATE WELL'S LOCATION WITH AN "X" IN SECTION BOX:

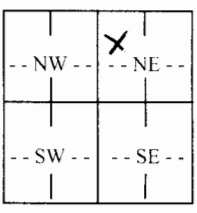

4 DEPTH OF COMPLETED WELL ... 14.5 ft.

Depth(s) Groundwater Encountered (1) 4.02 ft. (2)..... ft. (3)..... ft.
 WELL'S STATIC WATER LEVEL..... 11-14-07 ft. below land surface measured on mo/day/yr. 11-14-07
 Pump test data: Well water was..... ft. after..... hours pumping..... gpm
 Est. Yield.....gpm: Well water was..... ft. after..... hours pumping..... gpm
 WELL WATER TO BE USED AS: 5 Public water supply 8 Air conditioning 11 Injection well
 1 Domestic 3 Feedlot 6 Oil field water supply 9 Dewatering 12 Other (Specify below)
 2 Irrigation 4 Industrial 7 Domestic (lawn & garden) 10 Monitoring well
 Was a chemical/bacteriological sample submitted to Department? Yes No X.....; If yes, mo/day/yr
 Sample was submitted..... N/A..... Water well disinfected? Yes No X.....

5 TYPE OF CASING USED: 1 Steel 3 RMP (SR) 5 Wrought Iron 8 Concrete tile CASING JOINTS: Glued..... Clamped.....
2 PVC 4 ABS 6 Asbestos-Cement 9 Other (specify below) Welded.....
 7 Fiberglass Threaded

Blank casing diameter 2 in. to 4.5 ft., Diameter..... in. to ft., Diameter..... in. to ft.
 Casing height above land surface..... 0 in., Weight..... lbs./ft. Wall thickness or guage No. Sch 40

TYPE OF SCREEN OR PERFORATION MATERIAL:
 1 Steel 3 Stainless Steel 5 Fiberglass 7 PVC 9 ABS 11 Other (Specify).....
 2 Brass 4 Galvanized Steel 6 Concrete tile 8 RM (SR) 10 Asbestos-Cement 12 None used (open hole)

SCREEN OR PERFORATION OPENINGS ARE:
 1 Continuous slot 3 Mill slot 5 Gauzed wrapped 7 Torch cut 9 Drilled holes 11 None (open hole)
 2 Louvered shutter 4 Key punched 6 Wire wrapped 8 Saw Cut 10 Other (specify).....

SCREEN-PERFORATED INTERVALS: From 4.5 ft. to 14.5 ft., From ft. to ft.
 From..... ft. to ft., From ft. to ft.

GRAVEL PACK INTERVALS: From 3.5 ft. to 14.5 ft., From ft. to ft.
 From..... ft. to ft., From ft. to ft.

6 GROUT MATERIAL: 1 Neat cement 2 Cement grout 3 Bentonite 4 Other.....
 Grout Intervals: From 1 ft. to 3.5 ft., From ft. to ft., From ft. to ft.


What is the nearest source of possible contamination:
 1 Septic tank 4 Lateral lines 7 Pit privy 10 Livestock pens 13 Insecticide Storage 16 Other (specify below)
 2 Sewer lines 5 Cess pool 8 Sewage lagoon 11 Fuel storage 14 Abandoned water well
 3 Watertight sewer lines 6 Seepage pit 9 Feedyard 12 Fertilizer Storage 15 Oil well/gas well

Direction from well? How many feet?

FROM	TO	LITHOLOGIC LOG	FROM	TO	PLUGGING INTERVALS
C	6"	Grass			
1'	5'	Brown silty clay			
5'	14'	Gray silty clay			
	14.5'	Sandstone			

7 CONTRACTOR'S OR LANDOWNER'S CERTIFICATION: This water well was (1) constructed (2) reconstructed, or (3) plugged under my jurisdiction and was completed on (mo/day/year) 11-2-07 and this record is true to the best of my knowledge and belief. Kansas Water Well Contractor's License No. 759 This Water Well Record was completed on (mo/day/year) 11-11-07 under the business name of RAZEK Environmental, LLC by (signature) Andy Raze

INSTRUCTIONS: Use typewriter or ball point pen. PLEASE PRESS FIRMLY and PRINT clearly. Please fill in blanks, underline or circle the correct answers. Send top three copies to Kansas Department of Health and Environment, Bureau of Water, Geology Section, 1000 SW Jackson St., Suite 420, Topeka, Kansas 66612-1367. Telephone 785-296-5522. Send one to WATER WELL OWNER and retain one for your records. Fee of \$5.00 for each constructed well. Visit us at <http://www.kdheks.gov/waterwell/index.html>.

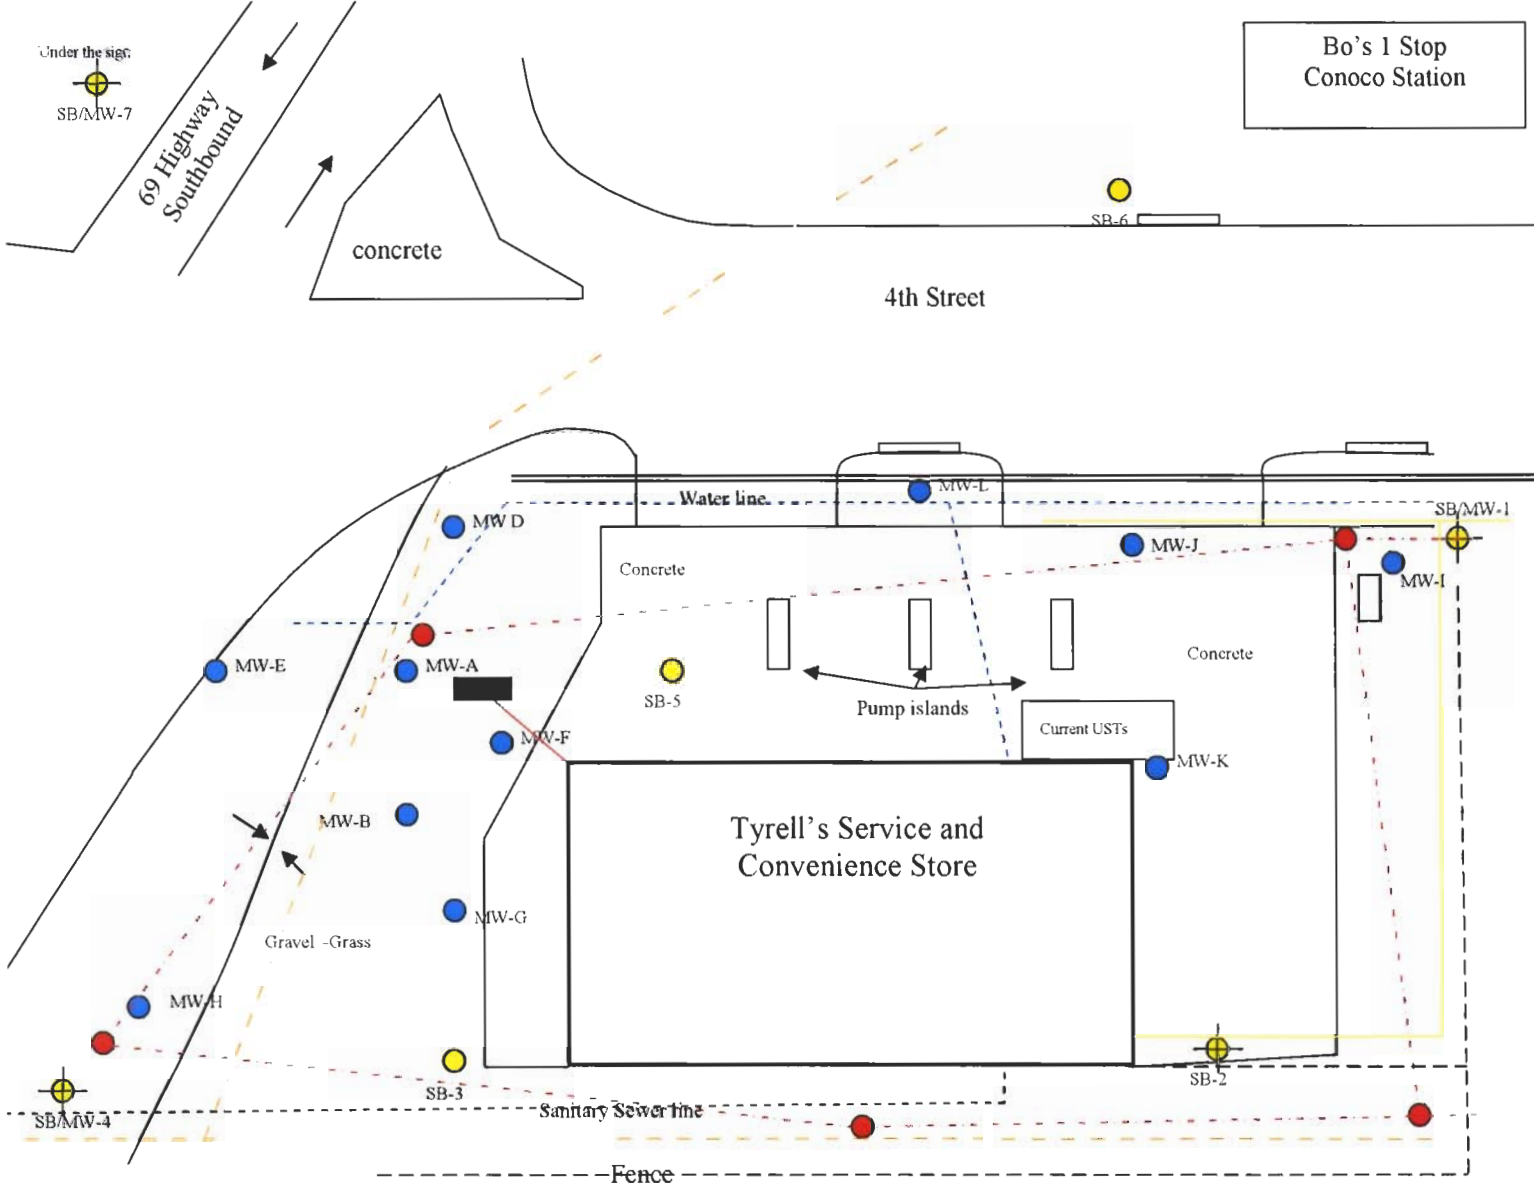

Bo's 1 Stop
Conoco Station

Under the sign:
SB/MW-7

69 Highway
Southbound

concrete

4th Street

SB-6

Water line

SB/MW-1

Concrete

Concrete

Pump islands

Current USTs


Tyrell's Service and
Convenience Store

Gravel -Grass

Sanitary Sewer line

Fence

- Existing wells
- ⊕ New well locations
- New boring locations
- Overhead power lines
- Telecom/Fiberoptic line
- Buried gas line
- - - Buried water line
- Storm sewer drain
- Site sign and buried electric line

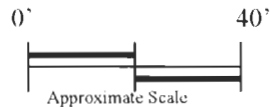

Boring/Well Location Map
Tyrell's Service and Store
117 W. Fourth Street
Pittsburg, KS

Figure 3

Apex # ERA03.003