


1 LOCATION OF WATER WELL: County: Crawford Fraction: NE 1/4 SE 1/4 SE 1/4 Section Number: 30 Township Number: T 30 S Range Number: R 25 E/W

Distance and direction from nearest town or city street address of well if located within city?
1002 S. Broadway, Pittsburg, KS

2 WATER WELL OWNER: Don Atkins, Trustee of the John Barbe Trust
 RR#, St. Address, Box #: B15 Ahtower Bldg., Tulsa, Ok 74103 Board of Agriculture, Division of Water Resources
 City, State, ZIP Code: Application Number:

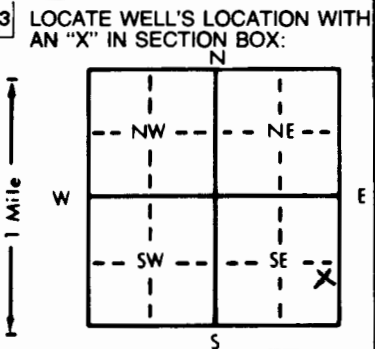

4 DEPTH OF COMPLETED WELL: 10 ft. ELEVATION:
 Depth(s) Groundwater Encountered 1. 2 ft. 2. ft. 3. ft.
 WELL'S STATIC WATER LEVEL: 2 ft. below land surface measured on mo/day/yr 5-22-96
 Pump test data: Well water was ft. after hours pumping gpm
 Est. Yield gpm: Well water was ft. after hours pumping gpm
 Bore Hole Diameter: 8.75 in. to 10 ft., and in. to ft.
 WELL WATER TO BE USED AS:
 1 Domestic 2 Irrigation 3 Feedlot 4 Industrial 5 Public water supply 6 Oil field water supply 7 Lawn and garden only 8 Air conditioning 9 Dewatering 10 Monitoring well environmental, #1 11 Injection well 12 Other (Specify below)
 Was a chemical/bacteriological sample submitted to Department? Yes.....No X.....; If yes, mo/day/yr sample was submitted
 Water Well Disinfected? Yes No

5 TYPE OF BLANK CASING USED:
 1 Steel 2 PVC 3 RMP (SR) 4 ABS 5 Wrought iron 6 Asbestos-Cement 7 Fiberglass 8 Concrete tile 9 Other (specify below) CASING JOINTS: Glued Clamped
 Blank casing diameter: 2 in. to 2 ft., Dia. in. to ft., Dia. in. to ft., Dia. in. to ft.
 Casing height above land surface: flush mount in., weight lbs./ft. Wall thickness or gauge No. Sch 40
 TYPE OF SCREEN OR PERFORATION MATERIAL:
 1 Steel 2 Brass 3 Stainless steel 4 Galvanized steel 5 Fiberglass 6 Concrete tile 7 PVC 8 RMP (SR) 9 ABS 10 Asbestos-cement 11 Other (specify) 12 None used (open hole)
 SCREEN OR PERFORATION OPENINGS ARE:
 1 Continuous slot 2 Louvered shutter 3 Mill slot 4 Key punched 5 Gauzed wrapped 6 Wire wrapped 7 Torch cut 8 Saw cut 9 Drilled holes 10 Other (specify) 11 None (open hole)
 SCREEN-PERFORATED INTERVALS: From 2 ft. to 10 ft., From ft. to ft.
 GRAVEL PACK INTERVALS: From 2 ft. to 10 ft., From ft. to ft.

6 GROUT MATERIAL: 1 Neat cement 2 Cement grout 3 Bentonite 4 Other
 Grout Intervals: From 0 ft. to 1.5 ft., From 1.5 ft. to 2 ft., From ft. to ft.
 What is the nearest source of possible contamination:
 1 Septic tank 2 Sewer lines 3 Watertight sewer lines 4 Lateral lines 5 Cess pool 6 Seepage pit 7 Pit privy 8 Sewage lagoon 9 Feedyard 10 Livestock pens 11 Fuel storage 12 Fertilizer storage 13 Insecticide storage 14 Abandoned water well 15 Oil well/Gas well 16 Other (specify below) USTs on site

Direction from well? How many feet?

| FROM | TO | LITHOLOGIC LOG | FROM | TO | PLUGGING INTERVALS |
|---|-----|--|------|----|--------------------|
| 0 | 15' | Concrete | | | |
| 5' | 2' | Sandy clay loam, dark brown, soft, | | | |
| 2' | 10' | Clay, orange brown, mottled, light gray silt | | | |
| Water level was 2' BGS instead of anticipated 7'. Screen was placed to monitor potential floating hydrocarbons from USTs at the site. | | | | | |

7 CONTRACTOR'S OR LANDOWNER'S CERTIFICATION: This water well was (1) constructed (2) reconstructed, or (3) plugged under my jurisdiction and was completed on (mo/day/year) 5-21-96 and this record is true to the best of my knowledge and belief. Kansas Water Well Contractor's License No. 603 This Water Well Record was completed on (mo/day/yr) 5-22-96 under the business name of Whitetail Services, Inc. by (signature) Deek C. Schum

OFFICE USE ONLY T R E/W SEC. 1/4 1/4 1/4