


1 LOCATION OF WATER WELL: County: Crawford Fraction: NE 1/4 SE 1/4 SE 1/4 Section Number: 30 Township Number: T 30 S Range Number: R 25 EW

Distance and direction from nearest town or city street address of well if located within city?
1002 S. Broadway, Pittsburg, KS

2 WATER WELL OWNER: Don Atkins, Trustee of the John Barbe Trust
 RR#, St. Address, Box #: 815 Ahittower Bldg, Tulsa, OK 74103
 City, State, ZIP Code: _____
 Board of Agriculture, Division of Water Resources
 Application Number: _____

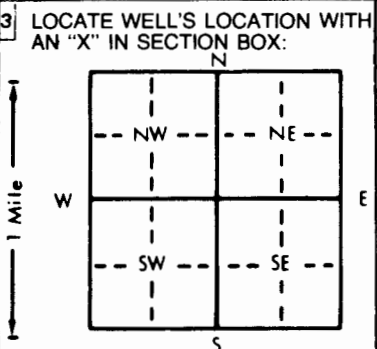

4 DEPTH OF COMPLETED WELL: 15 ft. ELEVATION: _____
 Depth(s) Groundwater Encountered 1. 5 ft. 2. _____ ft. 3. _____ ft.
 WELL'S STATIC WATER LEVEL: 5 ft. below land surface measured on mo/day/yr 7-18-96
 Pump test data: Well water was _____ ft. after _____ hours pumping _____ gpm
 Est. Yield _____ gpm: Well water was _____ ft. after _____ hours pumping _____ gpm
 Bore Hole Diameter: 7.5 in. to 15 in. and _____ in. to _____ in.
 WELL WATER TO BE USED AS:
 5 Public water supply 8 Air conditioning 11 Injection well
 1 Domestic 3 Feedlot 6 Oil field water supply 9 Dewatering 12 Other (Specify below)
 2 Irrigation 4 Industrial 7 Lawn and garden only 10 Monitoring well #7
 Was a chemical/bacteriological sample submitted to Department? Yes _____ No X If yes, mo/day/yr sample was submitted _____
 Water Well Disinfected? Yes _____ No _____

5 TYPE OF BLANK CASING USED:
 1 Steel 3 RMP (SR) 5 Wrought iron 8 Concrete tile CASING JOINTS: Glued _____ Clamped _____
2 PVC 4 ABS 6 Asbestos-Cement 9 Other (specify below) Welded _____
 7 Fiberglass _____ Threaded: Flush joint
 Blank casing diameter: 2 in. to 5 ft., Dia _____ in. to _____ ft., Dia _____ in. to _____ ft.
 Casing height above land surface: Flush mount in., weight _____ lbs./ft. Wall thickness or gauge No. sch. 40
 TYPE OF SCREEN OR PERFORATION MATERIAL:
 1 Steel 3 Stainless steel 5 Fiberglass 7 PVC 10 Asbestos-cement
 2 Brass 4 Galvanized steel 6 Concrete tile 8 RMP (SR) 11 Other (specify) _____
 9 ABS 12 None used (open hole)
 SCREEN OR PERFORATION OPENINGS ARE:
1 Continuous slot 3 Mill slot 5 Gauzed wrapped 8 Saw cut 11 None (open hole)
 2 Louvered shutter 4 Key punched 6 Wire wrapped 9 Drilled holes
 7 Torch cut 10 Other (specify) _____
 SCREEN-PERFORATED INTERVALS: From 5 ft. to 15 ft., From _____ ft. to _____ ft.
 From _____ ft. to _____ ft., From _____ ft. to _____ ft.
 GRAVEL PACK INTERVALS: From 4 ft. to 15 ft., From _____ ft. to _____ ft.
 From _____ ft. to _____ ft., From _____ ft. to _____ ft.

6 GROUT MATERIAL: 1 Neat cement 2 Cement grout 3 Bentonite 4 Other _____
 Grout intervals: From 0 ft. to 2 ft., From 2 ft. to 4 ft., From _____ ft. to _____ ft.
 What is the nearest source of possible contamination:
 1 Septic tank 4 Lateral lines 7 Pit privy 10 Livestock pens 14 Abandoned water well
 2 Sewer lines 5 Cess pool 8 Sewage lagoon 11 Fuel storage 15 Oil well/Gas well
 3 Watertight sewer lines 6 Seepage pit 9 Feedyard 12 Fertilizer storage 16 Other (specify below)
13 Insecticide storage USTs on site
 Direction from well? _____ How many feet? _____

FROM	TO	LITHOLOGIC LOG	FROM	TO	PLUGGING INTERVALS
0	2	Sandy clay loam, dark brown, soft			
2	11	Clay, orange-brown, mottled, light gray silt			
11	13	Fractured sandstone, light brown, soft with clay filled fissures			
13	15	Clay, brown-orange			
Water level was 5' BGS instead of anticipated 7'. Screen was placed to monitor potential floating hydrocarbons from USTs at the site. Flush mount manway was set in a 3'x3'x4" concrete pad.					

7 CONTRACTOR'S OR LANDOWNER'S CERTIFICATION: This water well was (1) constructed (2) reconstructed, or (3) plugged under my jurisdiction and was completed on (mo/day/year) 7-18-96 and this record is true to the best of my knowledge and belief. Kansas Water Well Contractor's License No. 693 This Water Well Record was completed on (mo/day/yr) 8-1-96 under the business name of Whitetail Services, Inc. by (signature) [Signature]

OFFICE USE ONLY
T
R
EW
SEC.
1/4
1/4
1/4