

The following correction(s) was made to the attached WWC-5 log, in order to file the item or to rectify lacking or incorrect information.

Fraction (1/4 1/4 1/4) Section-Township-Range changed:

listed as _____

changed to _____

Other changes made:

Initial statements: Pittsburg County

Changed to: Crawford County

verification method: street address of well on form, & KGS Geologic Map of Kansas initials: DRB date: 1/20/99

submitted by: Kansas Geological Survey, Data Resources Library, 1930 Constant Ave., Lawrence, KS 66047-3726
to: Kansas Dept of Health & Environment Bureau of Water Industrial Programs, Bldg 283, Forbes Field, KS 66620


NW-1

1 LOCATION OF WATER WELL: County: Pittsburg Fraction SW 1/4 SW 1/4 SW 1/4 Section Number 19 Township Number T 30 S Range Number R 25 EW

Distance and direction from nearest town or city street address of well if located within city? 1116 W 4TH

2 WATER WELL OWNER: Bo's Shop
 RR#, St. Address, Box #: 1116 W 4TH
 City, State, ZIP Code: Pittsburg, KS 66762
 Board of Agriculture, Division of Water Resources
 Application Number:

3 LOCATE WELL'S LOCATION WITH AN "X" IN SECTION BOX:

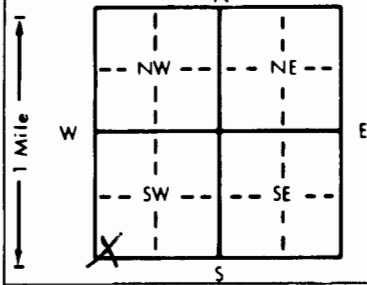

4 DEPTH OF COMPLETED WELL: 11.5 ft. ELEVATION: -

Depth(s) Groundwater Encountered 1. 11.5 ft. 2. - ft. 3. - ft.
 WELL'S STATIC WATER LEVEL 2.06 ft. below land surface measured on 9/20/98
 Pump test data: Well water was - ft. after - hours pumping - gpm
 Est. Yield - gpm: Well water was - ft. after - hours pumping - gpm
 Bore Hole Diameter: 2.625 in. to 11.5 ft., and - in. to - ft.
 WELL WATER TO BE USED AS:
 1 Domestic 3 Feedlot 6 Oil field water supply 9 Dewatering 12 Other (Specify below)
 2 Irrigation 4 Industrial 7 Lawn and garden only 10 Monitoring well NW-1
 Was a chemical/bacteriological sample submitted to Department? Yes - No X; If yes, mo/day/yr sample was submitted
 Water Well Disinfected? Yes - No X

5 TYPE OF CASING USED:
 1 Steel 3 RMP (SR) 5 Wrought iron 8 Concrete tile CASING JOINTS: Glued - Clamped -
2 PVC 4 ABS 6 Asbestos-Cement 9 Other (specify below) Welded -
 7 Fiberglass Threaded X

Blank casing diameter 2 in. to 4.5 ft., Dia - in. to - ft., Dia - in. to - ft.
 Casing height above land surface: Flush in., weight SCH 40 lbs./ft. Wall thickness or gauge No. -

TYPE OF SCREEN OR PERFORATION MATERIAL:
 1 Steel 3 Stainless steel 5 Fiberglass 8 RMP (SR) 10 Asbestos-cement
 2 Brass 4 Galvanized steel 6 Concrete tile 9 ABS 11 Other (specify) 7 PVC
 12 None used (open hole)

SCREEN OR PERFORATION OPENINGS ARE:
 1 Continuous slot 3 Mill slot 5 Gauzed wrapped 8 Saw cut 11 None (open hole)
 2 Louvered shutter 4 Key punched 6 Wire wrapped 9 Drilled holes
 7 Torch cut 10 Other (specify) -

SCREEN-PERFORATED INTERVALS: From 11.5 ft. to 4.5 ft., From - ft. to - ft., From - ft. to - ft.
SAND From - ft. to - ft., From - ft. to - ft., From - ft. to - ft.
 GRAVEL PACK INTERVALS: From 11.5 ft. to 3.5 ft., From - ft. to - ft., From - ft. to - ft.

6 GROUT MATERIAL:
 1 Neat cement 2 Cement grout 3 Bentonite 4 Other
 Grout Intervals: 3 From 3.5 ft. to 1.5 ft. 2 From 1.5 ft. to 0 ft., From - ft. to - ft.

What is the nearest source of possible contamination:
 1 Septic tank 4 Lateral lines 7 Pit privy 10 Livestock pens 14 Abandoned water well
 2 Sewer lines 5 Cess pool 8 Sewage lagoon 11 Fuel storage 15 Oil well/Gas well
 3 Watertight sewer lines 6 Seepage pit 9 Feedyard 12 Fertilizer storage 16 Other (specify below) Contaminated site
 13 Insecticide storage

Direction from well? How many feet?

FROM	TO	LITHOLOGIC LOG	FROM	TO	PLUGGING INTERVALS
0	1.5	concrete clay w/ some silt end of borehole			
1.5	11.5				
11.5	TD				

7 CONTRACTOR'S OR LANDOWNER'S CERTIFICATION: This water well was 1 constructed, (2) reconstructed, or (3) plugged under my jurisdiction and was completed on (mo/day/year) 9/29/98 and this record is true to the best of my knowledge and belief. Kansas Water Well Contractor's License No. 585 This Water Well Record was completed on (mo/day/yr) 10/1/98 under the business name of AEI by (signature) Adrian P. D. Duncan

OFFICE USE ONLY T R EW SEC. 1/4 1/4 1/4