

MW-3

WATER WELL PLUGGING RECORD Form WWC-5P KSA 82a-1212 ID NO.


Blank box for ID number

1 LOCATION OF WATER WELL: Fraction SE 1/4 SW 1/4 SW 1/4 SW 1/4 Section Number 20 Township Number T 30 S Range Number 25 [X] E [] W

Street/Rural Address of Well Location; if unknown, distance & direction from nearest town or intersection: If at owner's address, check here [X]

Global Positioning Systems (GPS) information: Latitude: 37.411361 (in decimal degrees) Longitude: 94.702306 (in decimal degrees) Elevation: Datum: [] WGS84, [X] NAD83, [] NAD27 Collection Method: [X] GPS unit (Make/Model: Garmin 60) [] Digital Map/Photo, [] Topographic Map, [] Land Survey Est. Accuracy: [] < 3 m, [X] 3-5 m, [] 5-15 m, [] > 15 m

2 WATER WELL OWNER: Del's Auto Sales RR#, St. Address, Box #: 215 E. 4th Street City, State ZIP Code: Pittsburg, KS 66762

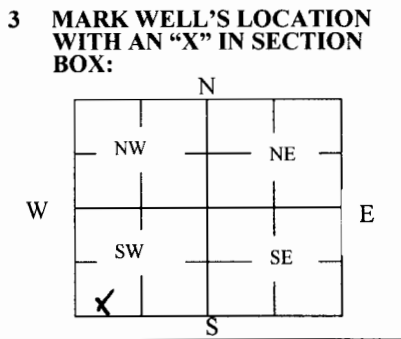

4 DEPTH OF WELL 11.8 ft. WELL'S STATIC WATER LEVEL 1.8 ft. WELL WAS USED AS: [] Domestic [] Irrigation [] Feedlot [] Industrial [] Public Water Supply [] Oil Field Water Supply [] Domestic (Lawn & Garden) [] Air Conditioning [] Dewatering [X] Monitoring [] Injection Well [] Other Was a chemical/bacteriological sample submitted to Department? Yes [] No [X]

5 TYPE OF BLANK CASING USED: [] Steel [X] PVC [] RMP (SR) [] ABS [] Wrought [] Asbestos-Cement [] Fiberglass [] Concrete Tile [] Other (Specify below) Blank casing diameter 2 in. Was casing pulled? Yes [X] No [] If yes, how much 11.8 ft Casing height above or below land surface Flush in.

6 GROUT PLUG MATERIAL: [] Neat cement [] Cement grout [X] Bentonite [] Other Grout Plug Intervals: From 11.8 ft. to 2 ft., From ___ ft. to ___ ft., From ___ to ___ ft. What is the nearest source of possible contamination: [] Septic tank [] Sewer lines [] Watertight sewer lines [] Lateral lines [] Cess pool [] Seepage pit [] Pit privy [] Sewage lagoon [] Feedyard [] Livestock pens [] Fuel Storage [] Fertilizer storage [] Insecticide storage [] Abandoned water well [] Oil well/Gas well [X] Other (specify below) Gas Station-UST Direction from well? How many feet?

Table with 6 columns: FROM, TO, PLUGGING MATERIALS, FROM, TO, PLUGGING MATERIALS. Row 1: 0, 2, Topsoil. Row 2: 2, 11.8, Bentonite-Grout.

7 CONTRACTOR'S OR LANDOWNER'S CERTIFICATION: This water well was plugged under my jurisdiction and was completed on (mo/day/year) 8/21/09 and this record is true to the best of my knowledge and belief. Kansas Water Well Contractor's License No. 710. This Water Well Record was completed on (mo/day/year) 9/8/09 under the business name of Below Ground Surface, Inc. by (signature) [Signature]

INSTRUCTIONS: Use typewriter or ballpoint pen. Please press firmly and print clearly. Please fill in blanks, underline or circle the correct answers. Send top three copies to Kansas Department of Health and Environment, Bureau of Water, Geology Section, 1000 SW Jackson St., Ste. 420, Topeka, Kansas 66612-1367. Telephone: 785/296-5524. Send one to Water Well Owner and retain one for your records. Visit us at http://www.kdheks.gov/waterwell/index.html.

Check one: [] White Copy [] Blue Copy [] Pink Copy