


Constructed 12 @ 310

WATER WELL PLUGGING RECORD Form WWC-5P KSA 82a-1212 ID NO. []

1 LOCATION OF WATER WELL: Fraction NE 1/4 NE 1/4 SE 1/4 1/4 Section Number 28 Township Number T 30 S Range Number 25 [X] E [] W

Street/Rural Address of Well Location; if unknown, distance & direction from nearest town or intersection: If at owner's address, check here [] Global Positioning Systems (GPS) information: Latitude: 37.402512 (in decimal degrees) Longitude: -94.670750 (in decimal degrees) Elevation: Datum: [] WGS84, [] NAD83, [] NAD27 Collection Method: [X] GPS unit (Make/Model: MAGELLEN) [] Digital Map/Photo, [] Topographic Map, [] Land Survey Est. Accuracy: [] < 3 m, [] 3-5 m, [] 5-15 m, [] > 15 m

2 WATER WELL OWNER: PITTSBURGH WATER RR#, St. Address, Box #: 602 S. Free King Highway City, State ZIP Code: PITTSBURGH, KS 66762

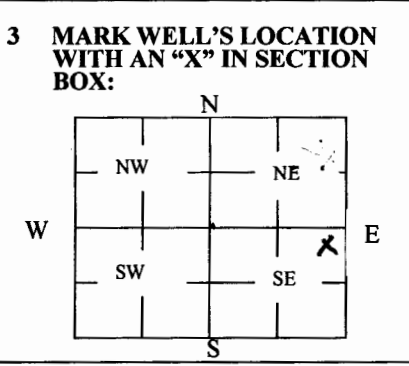

4 DEPTH OF WELL 310 ft. WELL'S STATIC WATER LEVEL NA ft. WELL WAS USED AS: [] Domestic [] Irrigation [] Feedlot [] Industrial [] Public Water Supply [] Oil Field Water Supply [] Domestic (Lawn & Garden) [] Air Conditioning [] Dewatering [] Monitoring [] Injection Well [X] Other Geothermal Was a chemical/bacteriological sample submitted to Department? Yes [] No [X]

5 TYPE OF BLANK CASING USED: [] Steel [] PVC [] RMP (SR) [] ABS [] Wrought [] Asbestos-Cement [] Fiberglass [] Concrete Tile [X] Other (Specify below) N/A Blank casing diameter in. Was casing pulled? Yes [] No [] If yes, how much Casing height above or below land surface in.

6 GROUT PLUG MATERIAL: [] Neat cement [] Cement grout [X] Bentonite [] Other Grout Plug Intervals: From 0 ft. to 310 ft., From ft. to ft., From to ft. What is the nearest source of possible contamination: [] Septic tank [] Sewer lines [] Watertight sewer lines [] Lateral lines [] Cess pool [] Seepage pit [] Pit privy [] Sewage lagoon [] Feedyard [] Livestock pens [] Fuel Storage [] Fertilizer storage [] Insecticide storage [] Abandoned water well [] Oil well/Gas well [X] Other (specify below) BUILDING Direction from well? EAST How many feet? 60 FT

Table with columns: FROM, TO, PLUGGING MATERIALS. Rows: 0-20 (YELLOW CLAY), 20-60 (GRAY SHALE), 60-80 (COAL), 80-190 (GRAY SHALE), 190-310 (LIMESTONE)

7 CONTRACTOR'S OR LANDOWNER'S CERTIFICATION: This water well was plugged under my jurisdiction and was completed on (mo/day/year) 01-06-11 and this record is true to the best of my knowledge and belief. Kansas Water Well Contractor's License No. 812 This Water Well Record was completed on (mo/day/year) 01/19/11 under the business name of Environmental Loop Service, Inc by (signature) Richard Moore

INSTRUCTIONS: Use typewriter or ballpoint pen. Please press firmly and print clearly. Please fill in blanks, underline or circle the correct answers. Send top three copies to Kansas Department of Health and Environment, Bureau of Water, Geology Section, 1000 SW Jackson St., Ste. 420, Topeka, Kansas 66612-1367. Telephone: 785/296-5524. Send one to Water Well Owner and retain one for your records. Visit us at http://www.kdheks.gov/waterwell/index.html.

Check one: [X] White Copy [] Blue Copy [] Pink Copy