

WATER WELL RECORD

Per plugging record
Form WWC-5


Division of Water Resources; App. No.

MW 9

1 LOCATION OF WATER WELL: MW-9
 County: CRAWFORD Fraction SW SE NE NW Section Number 19 Township Number T 30 S Range Number R 25 W

Distance and direction from nearest town or city street address of well if located within city? EAST OF PINE APPROX 20' and North 11th 15th ST
Global Positioning Systems (decimal degrees, min. of 4 digits)
 Latitude: 37° 25' 09.86" N
 Longitude: 94° 42' 22.68" W
 Elevation: 933
 Datum: WGS 84
 Data Collection Method: AUG 8, 2012

2 WATER WELL OWNER: Glandby
 RR#, St. Address, Box # : 1308 NORTH WALNUT STREET
 City, State, ZIP Code : PITTSBURG KS 66762

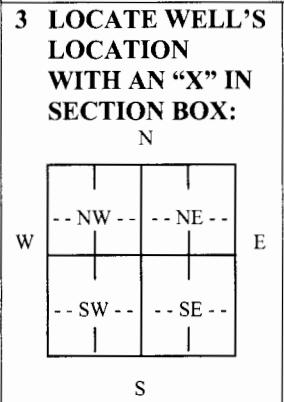

4 DEPTH OF COMPLETED WELL 16 ft.

Depth(s) Groundwater Encountered (1)..... 5.62 ft. (2)..... ft. (3)..... ft.
 WELL'S STATIC WATER LEVEL..... ft. below land surface measured on mo/day/yr.....
 Pump test data: Well water was.....ft. after..... hours pumping..... gpm
 Est. Yield.....gpm: Well water was.....ft. after..... hours pumping..... gpm
WELL WATER TO BE USED AS: 5 Public water supply 8 Air conditioning 11 Injection well
 1 Domestic 3 Feedlot 6 Oil field water supply 9 Dewatering 12 Other (Specify below)
 2 Irrigation 4 Industrial 7 Domestic (lawn & garden) 10 Monitoring well

Was a chemical/bacteriological sample submitted to Department? Yes No; If yes, mo/day/yr
 Sample was submitted..... Water well disinfected? Yes No

5 TYPE OF CASING USED: 5 Wrought Iron 8 Concrete tile CASING JOINTS: Glued..... Clamped.....
 1 Steel 3 RMP (SR) 6 Asbestos-Cement 9 Other (specify below) Welded.....
 2 PVC 4 ABS 7 Fiberglass Threaded.

Blank casing diameter 8 in. to 1 ft., Diameter in. to ft., Diameter in. to ft.
 Casing height above land surface..... 0 in., Weight..... lbs./ft. Wall thickness or gauge No. Sch 40

TYPE OF SCREEN OR PERFORATION MATERIAL:
 1 Steel 3 Stainless Steel 5 Fiberglass 7 PVC 9 ABS 11 Other (Specify)
 2 Brass 4 Galvanized Steel 6 Concrete tile 8 RM (SR) 10 Asbestos-Cement 12 None used (open hole)

SCREEN OR PERFORATION OPENINGS ARE:
 1 Continuous slot 2 Mill slot 5 Gauzed wrapped 7 Torch cut 9 Drilled holes 11 None (open hole)
 2 Louvered shutter 4 Key punched 6 Wire wrapped 8 Saw Cut 10 Other (specify)

SCREEN-PERFORATED INTERVALS: From..... 16 ft. to 6 ft., From ft. to ft.
 From..... ft. to ft., From ft. to ft.

GRAVEL PACK INTERVALS: From..... 16 ft. to 4 ft., From ft. to ft.
 From..... ft. to ft., From ft. to ft.

6 GROUT MATERIAL: 1 Neat cement 2 Cement grout 3 Bentonite 4 Other
 Grout Intervals: From 4 ft. to 1 ft., From ft. to ft., From ft. to ft.

What is the nearest source of possible contamination:
 1 Septic tank 4 Lateral lines 7 Pit privy 10 Livestock pens 13 Insecticide Storage 16 Other (specify below)
 2 Sewer lines 5 Cess pool 8 Sewage lagoon 11 Fuel storage 14 Abandoned water well below)
3 Watertight sewer lines 6 Seepage pit 9 Feedyard 12 Fertilizer Storage 15 Oil well/gas well

Direction from well? .. WEST How many feet?

FROM	TO	LITHOLOGIC LOG	FROM	TO	PLUGGING INTERVALS
0	3.5	TOPSOIL			
3.5	5	S.H brown, low plasticity loose			
5	8.5	Same as above			
8.5	9.5	Coal, black, medium to coarse loose			
9.5	10.0	Clayey S.H Gray low plasticity moist			
10	15	clay mottled Gray/black dry			
15	16	Clay/silt gray mottled orange and black some moisture			

7 CONTRACTOR'S OR LANDOWNER'S CERTIFICATION: This water well was (1) constructed, (2) reconstructed, or (3) plugged under my jurisdiction and was completed on (mo/day/year) ... 8-1-2012 ... and this record is true to the best of my knowledge and belief.
 Kansas Water Well Contractor's License No. 753 This Water Well Record was completed on (mo/day/year) ... 8-7-12
 under the business name of ENVIRONMENTAL WORK INC by (signature) [Signature]

INSTRUCTIONS: Use typewriter or ball point pen. PLEASE PRESS FIRMLY and PRINT clearly. Please fill in blanks, underline or circle the correct answers. Send top three copies to Kansas Department of Health and Environment, Bureau of Water, Geology Section, 1000 SW Jackson St., Suite 420, Topeka, Kansas 66612-1367. Telephone 785-296-5522. Send one to WATER WELL OWNER and retain one for your records. Fee of \$5.00 for each constructed well. Visit us at <http://www.kdhe.state.ks.us/geo/waterwells>.