


1 LOCATION OF WATER WELL: Fraction SW 1/4 SW 1/4 SE 1/4 Section Number 19 Township Number T 30 S Range Number R 25 E

County: Crawford Distance and direction from nearest town or city street address of well if located within city? 434 W 4th St, Pittsburg, KS

2 WATER WELL OWNER: Casey's General Store RR#, St. Address, Box #: PO Box 3001 City, State, ZIP Code: Ankeny, IA 50021-3001 Board of Agriculture, Division of Water Resources Application Number:

3 LOCATE WELL'S LOCATION WITH AN "X" IN SECTION BOX:

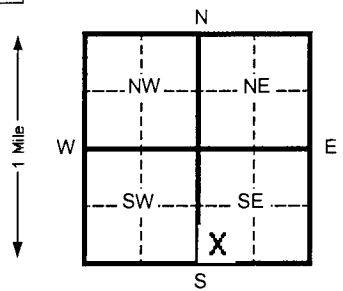

4 DEPTH OF COMPLETED WELL 15 ft. ELEVATION: 935.68

Depth(s) Groundwater Encountered 1.5 14 ft. 2 ft. 3 ft. WELL'S STATIC WATER LEVEL 8.72 ft. below land surface measured on mo/day/yr 06/04/13 Pump test data: Well water was Ft. after hours pumping Gpm Est. Yield Gpm: Well water was Ft. after Hours pumping Gpm Bore Hole Diameter 6.25 in. to 15 ft. and in. to ft. WELL WATER TO BE USED AS: 5 Public water supply 8 Air conditioning 11 Injection well 1 Domestic 3 Feed lot 6 Oil field water supply 9 Dewatering 12 Other (Specify below) 2 Irrigation 4 Industrial 7 Lawn and garden (domestic) 10 Monitoring well MW-6 Was a chemical/bacteriological sample submitted to Department? Yes No X If yes, mo/day/yr sample was Submitted Water Well Disinfected? Yes No X

5 TYPE OF BLANK CASING USED: 1 Steel 2 PVC 3 RMP (SR) 4 ABS 5 Wrought Iron 6 Asbestos-Cement 7 Fiberglass 8 Concrete tile 9 Other (specify below) 10 Asbestos-cement CASING JOINTS: Glued Clamped Welded Threaded X

Blank casing diameter 2 in. to 5 in. Dia SCH 40 Casing height above land surface FLUSH in., weight Lbs./ft. Wall thickness or gauge No. TYPE OF SCREEN OR PERFORATION MATERIAL: 1 Steel 2 Brass 3 Stainless steel 4 Galvanized steel 5 Fiberglass 6 Concrete tile 7 PVC 8 RMP (SR) 9 ABS 10 Asbestos-cement 11 Other (specify) 12 None used (open hole)

SCREEN OR PERFORATION OPENINGS ARE: 1 Continuous slot 2 Louvered shutter 3 Mill slot 4 Key punched 5 Gauzed wrapped 6 Wire wrapped 7 Torch cut 8 Saw cut 9 Drilled holes 10 Other (specify) 11 None (open hole)

SCREEN-PERFORATED INTERVALS: From 5 ft. to 15 ft. SAND PACK INTERVALS: From 4 ft. to 15 ft.

6 GROUT MATERIAL: 1 Neat cement 2 Cement grout 3 Bentonite 4 Other Grout Intervals From 2 0.5 ft. to 2 Ft. From 3 2 to 4 ft. From ft. to ft.

What is the nearest source of possible contamination: 1 Septic tank 2 Sewer lines 3 Watertight sewer lines 4 Lateral lines 5 Cess pool 6 Seepage pit 7 Pit privy 8 Sewage lagoon 9 Feedyard 10 Livestock pens 11 Fuel storage 12 Fertilizer storage 13 Insecticide storage 14 Abandoned water well 15 Oil well/ Gas well 16 Other (specify below) Contaminated Site

Direction from well? How many feet?

Table with 6 columns: FROM, TO, CODE, LITHOLOGIC LOG, FROM, TO, PLUGGING INTERVALS. Rows include Topsoil (0-1.5), Silty Clay (1.5-9.5), Shale, grey/green (9.5-15), End of Borehole (15-TD).

7 CONTRACTOR'S OR LANDOWNER'S CERTIFICATION: This water well was (x) constructed, (2) reconstructed, or (3) plugged under my jurisdiction and was Completed on (mo/day/yr) 06/03/13 And this record is true to the best of my knowledge and belief. Kansas Water Well Contractor's License No. 585 This Water Well Record was completed on (mo/day/yr) 06/28/13 under the business name of Associated Environmental, Inc. By (signature) Bradley J. Johnson

INSTRUCTIONS: Please fill in blanks and circle the correct answers. Send three copies to Kansas Department of Health and Environment, Bureau of Water, Topeka, Kansas 66620-0001. Telephone: 913-296-5545. Send one to WATER WELL OWNER and retain one for your records.

OFFICE USE ONLY T R SEC

Handwritten signature of Bradley J. Johnson