

1 LOCATION OF WATER WELL: County: Crawford	Fraction NW ¼ SW ¼ NW ¼ NW ¼	Section Number 29	Township Number T 30 S	Range Number 25 <input checked="" type="checkbox"/> E <input type="checkbox"/> W
---	---------------------------------	----------------------	---------------------------	---


Street/Rural Address of Well Location: if unknown, distance & direction from nearest town or intersection: If at owner's address, check here   
122 N Broadway, Pittsburg

Global Positioning Systems (GPS) information:  
Latitude: NA (in decimal degrees)  
Longitude: NA (in decimal degrees)  
Elevation: NA

Horizontal Datum  WGS84.  NAD83.  NAD27  
Collection Method:

2 WATER WELL OWNER: KDHE  
RR#. St. Address. Box #: 1000 SW Jackson  
City, State ZIP Code: Topeka, KS 66612

GPS unit (Make/model: \_\_\_\_\_)  
 Digital Map/Photo.  Topographic Map  Land Survey  
Est. Accuracy:  <3 m.  3-5 m.  5-15 m.  >15 m

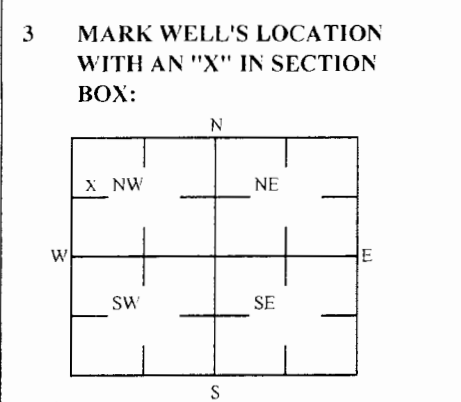

4 DEPTH OF WELL 14.5 ft. MW1  
WELL'S STATIC WATER LEVEL NA ft  
WELL WAS USED AS:  
 Domestic  Public Water Supply  Dewatering  
 Irrigation  Oil Field Water Supply  Monitoring  
 Feedlot  Domestic (Lawn & Garden)  Injection Well  
 Industrial  Air Conditioning  Other \_\_\_\_\_  
Was a chemical/bacteriological sample submitted to Department? Yes  No

5 TYPE OF BLANK CASING USED:  
 Steel  RMP (SR)  Wrought  Fiberglass  Other (Specific below)  
 PVC  ABS  Asbestos-Cement  Concrete Tile  
Blank casing diameter 2 in. Was casing pulled? Yes  No  If yes, how much 3ft  
Casing height above or below land surface NA in.

6 GROUT PLUG MATERIAL:  Neat cement  Cement grout  Bentonite  Other Asphalt: 0-1ft: Soil: 1-3ft  
Grout Plug Intervals: From 3 ft to 14.5 ft. From \_\_\_\_\_ ft to \_\_\_\_\_ ft. From \_\_\_\_\_ ft to \_\_\_\_\_ ft.  
What is the nearest source of possible contamination:  
 Septic tank  Seepage pit  Fuel storage  Other (specify below) \_\_\_\_\_  
 Sewer lines  Pit privy  Fertilizer storage \_\_\_\_\_  
 Watertight sewer lines  Sewage lagoon  Insecticide storage \_\_\_\_\_  
 Lateral lines  Feed yard  Abandoned water well Direction from well? \_\_\_\_\_  
 Cess pool  Livestock pens  Oil well/Gas well How many feet? \_\_\_\_\_

FROM	TO	PLUGGING MATERIALS	FROM	TO	PLUGGING MATERIALS
0	1	Asphalt			
1	3	Soil			
3	14.5	Bentonite			
KDHE ID: Dobbs Parts & Service: U3-019-14894					

7 CONTRACTOR'S OR LANDOWNER'S CERTIFICATION: This water well was plugged under my jurisdiction and was completed on (mo/day/year) 5/30/2018 and this record is true to the best of my knowledge and belief. Kansas Water Contractor's License No. 757. This Water Well Record was completed on (mo/day/year) 5/31/2018 under the business name of Larsen & Associates, Inc. By (signature) \_\_\_\_\_

Send one white copy to Kansas Department of Health & Environment, Geology Section, 1000 SW Jackson Street, Ste. 420, Topeka, KS 66612-1367. Send one copy to WATER WELL OWNER and retain one for your records  
Visit us at <http://www.kdheks.gov/waterwell/index.html> Telephone 785-296-5524.