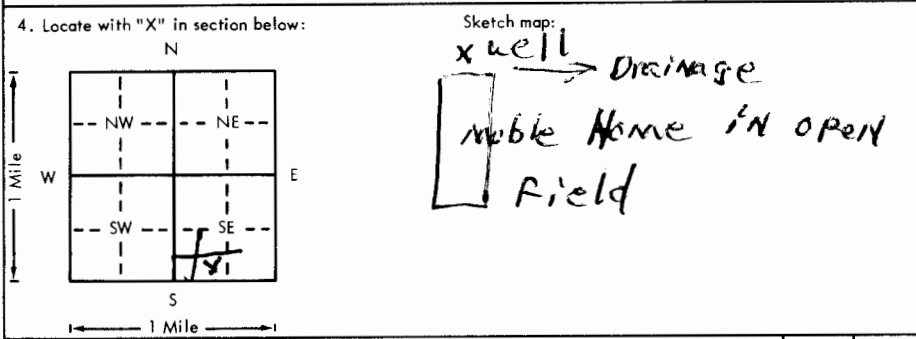


USE TYPEWRITER OR BALL POINT PEN-PRESS FIRMLY, PRINT CLEARLY.

WATER WELL RECORD
KSA 82a-1201-1215

Kansas Department of Health and Environment-Division of Environment
(Water well Contractors)
Topeka, Kansas 66620

1. Location of well: County Cowley Fraction SE 1/4 SW 1/4 SE 1/4 Section number 1 Township number T 30 S R 3 Range number E 1/4	
2. Distance and direction from nearest town or city: 2 W 2 N 1/4 W of Rock Ks. 3. Owner of well: Florence Elliott R.R. or street: 3601 E Duham City, state, zip code: Wichita Ks. 67210	
4. Locate with "X" in section below: 	
5. Type and color of material	
Top Soil	From 0 To 1
Clay Redish brown	1 4
Limestone yellow	4 27
Shale Light gray	27 34
clay Rusty Red	34 45
shale blue gray	45 59
Limestone yellow	59 69
(Water at 59')	
(Use a second sheet if needed)	
18. Elevation: Topography: <input checked="" type="checkbox"/> Hill <input checked="" type="checkbox"/> Slope <input type="checkbox"/> Upland <input type="checkbox"/> Valley	19. Remarks: owner w'll install concrete slab
6. Bore hole dia. 9 in. Completion date 2-15-79 Well depth 69 ft.	
7. <input checked="" type="checkbox"/> Cable tool <input type="checkbox"/> Rotary <input type="checkbox"/> Driven <input type="checkbox"/> Dug <input type="checkbox"/> Hollow rod <input type="checkbox"/> Jetted <input type="checkbox"/> Bored <input type="checkbox"/> Reverse rotary	
8. Use: <input checked="" type="checkbox"/> Domestic <input type="checkbox"/> Public supply <input type="checkbox"/> Industry <input type="checkbox"/> Irrigation <input type="checkbox"/> Air conditioning <input type="checkbox"/> Stock <input type="checkbox"/> Lawn <input type="checkbox"/> Oil field water <input type="checkbox"/> Other	
9. Casing: Material PES Height: Above <input type="checkbox"/> Below <input checked="" type="checkbox"/> Threading: <input type="checkbox"/> Threaded <input checked="" type="checkbox"/> Welded 3/16 Surface 16 in. RMP <input checked="" type="checkbox"/> PVC <input type="checkbox"/> Weight <input type="checkbox"/> lbs./ft. Dia. 5 in. to 6.9 ft. depth Wall Thickness: inches or Dia. <input type="checkbox"/> in. to <input type="checkbox"/> ft. depth Gage No. 1200	
10. Screen: Manufacturer's name Sunflower Type RMP Dia. 5.75 Slot/gouze 1/16 Length 10' Set between 59 ft. and 67 ft. Gravel pack? <input checked="" type="checkbox"/> Size range of material 10 to 35	
11. Static water level: 24 ft. below land surface Date 2-15-79 mo./day/yr.	
12. Pumping level below land surfaces: NR ft. after <input type="checkbox"/> hrs. pumping <input type="checkbox"/> g.p.m. <input type="checkbox"/> ft. after <input type="checkbox"/> hrs. pumping <input type="checkbox"/> g.p.m. Estimated maximum yield <input type="checkbox"/> g.p.m.	
13. Water sample submitted: <input type="checkbox"/> Yes <input checked="" type="checkbox"/> No Date <input type="checkbox"/> mo./day/yr.	
14. Well head completion: <input type="checkbox"/> Pitless adapter 16 inches above grade	
15. Well grouted? <input checked="" type="checkbox"/> yes With: <input type="checkbox"/> Neat cement <input type="checkbox"/> Bentonite <input type="checkbox"/> Concrete Depth: From 10 ft. to 0 ft.	
16. Nearest source of possible contamination: NR ft. open field Direction field Type <input type="checkbox"/> Well disinfected upon completion? <input checked="" type="checkbox"/> Yes <input type="checkbox"/> No	
17. Pump: <input checked="" type="checkbox"/> Not installed Manufacturer's name <input type="checkbox"/> Model number <input type="checkbox"/> HP <input type="checkbox"/> Volts <input type="checkbox"/> Length of drop pipe <input type="checkbox"/> ft. capacity <input type="checkbox"/> g.p.m. Type: <input type="checkbox"/> Submersible <input type="checkbox"/> Turbine <input type="checkbox"/> Jet <input type="checkbox"/> Reciprocating <input type="checkbox"/> Centrifugal <input type="checkbox"/> Other	
20. Water well contractor's certification: This well was drilled under my jurisdiction and this report is true to the best of my knowledge and belief. Braddy water wells 363 Business name License No. 82 Douglas KS Address Signed Richard Braddy Date 3-12-79 Authorized representative	

T 30
 R 3
 SE 1/4
 SW 1/4
 SE 1/4
 E 1/4

Forward the white, blue and pink copies to the Department of Health and Environment

Form WWC-5