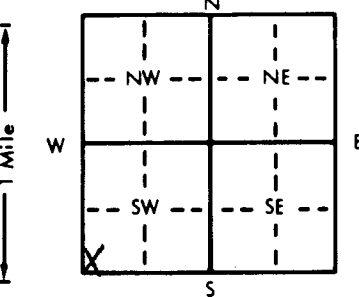


1 LOCATION OF WATER WELL: Fraction SW 1/4 SW 1/4 SW 1/4 Section Number 18 Township Number T 30 S Range Number R 3 E E/W
 County: COWLEY

Distance and direction from nearest town or city street address of well if located within city?
5 1/2 E. of Mulvane, Ks., 1/2 S. of K-15 Highway, Mulvane, Ks.

2 WATER WELL OWNER: Jerry Bennett
 RR#, St. Address, Box # : R#1 Board of Agriculture, Division of Water Resources
 City, State, ZIP Code : Mulvane, Ks. Application Number:

3 LOCATE WELL'S LOCATION WITH AN "X" IN SECTION BOX:

 4 DEPTH OF COMPLETED WELL... 95 ft. ELEVATION:
 Depth(s) Groundwater Encountered 1... 53 ft. 2... ft. 3... ft.
 WELL'S STATIC WATER LEVEL... 53 ft. below land surface measured on mo/day/yr 5/26/81
 Pump test data: Well water was ... ft. after ... hours pumping ... gpm
 Est. Yield ... gpm: Well water was ... ft. after ... hours pumping ... gpm
 Bore Hole Diameter... 11 in. to ... ft., and ... in. to ... ft.
 WELL WATER TO BE USED AS:
5 Public water supply 8 Air conditioning 11 Injection well
1 Domestic 3 Feedlot 6 Oil field water supply 9 Dewatering 12 Other (Specify below)
2 Irrigation 4 Industrial 7 Lawn and garden only 10 Observation well
 Was a chemical/bacteriological sample submitted to Department? Yes... No... X...; If yes, mo/day/yr sample was submitted
 Water Well Disinfected? Yes X No

5 TYPE OF BLANK CASING USED:
1 Steel 3 RMP (SR) 6 Asbestos-Cement 9 Other (specify below) Cer-Mac Welded
2 PVC 4 ABS 7 Fiberglass SDR-26 Styrene Threaded
 Blank casing diameter ... 5 in. to ... 50 ft., Dia ... in. to ... ft., Dia ... in. to ... ft.
 Casing height above land surface... 12 in., weight ... lbs./ft. Wall thickness or gauge No. ... 203
 TYPE OF SCREEN OR PERFORATION MATERIAL:
1 Steel 3 Stainless steel 5 Fiberglass 8 RMP (SR) 11 Other (specify) ... SDR-26
2 Brass 4 Galvanized steel 6 Concrete tile 9 ABS 12 None used (open hole)
 SCREEN OR PERFORATION OPENINGS ARE:
1 Continuous slot 3 Mill slot 6 Wire wrapped 8 Saw cut .06 11 None (open hole)
2 Louvered shutter 4 Key punched 7 Torch cut 9 Drilled holes 10 Other (specify) ...
 SCREEN-PERFORATED INTERVALS: From ... 50 ft. to ... 95 ft., From ... ft. to ... ft.
 GRAVEL PACK INTERVALS: From ... 14 ft. to ... 95 ft., From ... ft. to ... ft.

6 GROUT MATERIAL: 1 Neat cement 2 Cement grout 3 Bentonite 4 Other
 Grout intervals: From ... 40" ft. to ... 14 ft., From ... ft. to ... ft., From ... ft. to ... ft.
 What is the nearest source of possible contamination:
1 Septic tank 4 Lateral lines 7 Pit privy 10 Livestock pens 14 Abandoned water well
2 Sewer lines 5 Cess pool 8 Sewage lagoon 11 Fuel storage 15 Oil well/Gas well
3 Watertight sewer lines 6 Seepage pit 9 Feedyard 12 Fertilizer storage 16 Other (specify below)
13 Insecticide storage
 Direction from well? West How many feet? 150

FROM	TO	LITHOLOGIC LOG	FROM	TO	LITHOLOGIC LOG
0	3	Topsoil			
3	7	Clay			
7	41	Brown Shale			
41	95	Grey Shale			

7 CONTRACTOR'S OR LANDOWNER'S CERTIFICATION: This water well was (1) constructed, (2) reconstructed, or (3) plugged under my jurisdiction and was completed on (mo/day/year) ... 5/26/81 ... and this record is true to the best of my knowledge and belief. Kansas Water Well Contractor's License No. ... 236 ... This Water Well Record was completed on (mo/day/yr) 7-24-81 under the business name of Harp Well & Pump Serv., Inc. by (signature) M. Arnold

INSTRUCTIONS: Use typewriter or ball point pen, PLEASE PRESS FIRMLY and PRINT clearly. Please fill in blanks, underline or circle the correct answers. Send top three copies to Kansas Department of Health and Environment, Division of Environment, Environmental Geology Section, Topeka, KS 66620. Send one to WATER WELL OWNER and retain one for your records.

OFFICE USE ONLY

T

30

R

3

BW

SEC.

18

SW 1/4 SW 1/4 SW 1/4 SW 1/4