


1 LOCATION OF WATER WELL: Fraction SE 1/4 NE 1/4 NE 1/4 Section Number 30 Township Number T 30 S Range Number R 3 EW  
 County: COWLEY

Distance and direction from nearest town or city street address of well if located within city?  
BELLWIN LAKES Subdiv Lot # 8

2 WATER WELL OWNER: RODNEY MORRELL  
 RR#, St. Address, Box #: RR # 2  
 City, State, ZIP Code: UPDALL KS 67146  
 Board of Agriculture, Division of Water Resources  
 Application Number:

3 LOCATE WELL'S LOCATION WITH AN "X" IN SECTION BOX:

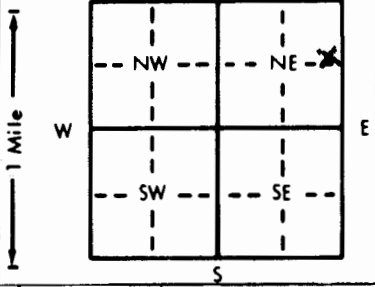

4 DEPTH OF COMPLETED WELL: 90 ft. ELEVATION:  
 Depth(s) Groundwater Encountered 1. 81 ft. 2. ft. 3. ft.  
 WELL'S STATIC WATER LEVEL: 37 ft. below land surface measured on mo/day/yr  
 Pump test data: Well water was ft. after hours pumping gpm  
 Est. Yield 20 gpm: Well water was ft. after hours pumping gpm  
 Bore Hole Diameter: 10 in. to .ft., and .in. to .ft.

WELL WATER TO BE USED AS:  
 1 Domestic  3 Feedlot  6 Oil field water supply  9 Dewatering  12 Other (Specify below)  
 2 Irrigation  4 Industrial  7 Lawn and garden only  10 Monitoring well

Was a chemical/bacteriological sample submitted to Department? Yes.....No.....  
 If yes, mo/day/yr sample was submitted  
 Water Well Disinfected?  Yes  No

5 TYPE OF BLANK CASING USED:  
 1 Steel  3 RMP (SR)  5 Wrought iron  8 Concrete tile  CASING JOINTS:  Glued  Clamped  
 2 PVC  4 ABS  6 Asbestos-Cement  9 Other (specify below)  Welded  
 7 Fiberglass  Threaded

Blank casing diameter 5 in. to .ft., Dia. in. to .ft., Dia. in. to .ft.  
 Casing height above land surface +12 in., weight 200 lbs./ft. Wall thickness or gauge No.

TYPE OF SCREEN OR PERFORATION MATERIAL:  
 1 Steel  3 Stainless steel  5 Fiberglass  8 RMP (SR)  10 Asbestos-cement   
 2 Brass  4 Galvanized steel  6 Concrete tile  9 ABS  11 Other (specify)   
 12 None used (open hole)

SCREEN OR PERFORATION OPENINGS ARE:  
 1 Continuous slot  3 Mill slot  5 Gauzed wrapped  8 Saw cut  11 None (open hole)  
 2 Louvered shutter  4 Key punched  6 Wire wrapped  9 Drilled holes   
 7 Torch cut  10 Other (specify)

SCREEN-PERFORATED INTERVALS: From 70 ft. to 90 ft., From .ft. to .ft.  
 GRAVEL PACK INTERVALS: From 20 ft. to 90 ft., From .ft. to .ft.

6 GROUT MATERIAL: 1 Neat cement  2 Cement grout  3 Bentonite  4 Other   
 Grout Intervals: From 3 ft. to 20 ft., From .ft. to .ft., From .ft. to .ft.

What is the nearest source of possible contamination:  
 1 Septic tank  4 Lateral lines  7 Pit privy  10 Livestock pens  14 Abandoned water well   
 2 Sewer lines  5 Cess pool  8 Sewage lagoon  11 Fuel storage  15 Oil well/Gas well   
 3 Watertight sewer lines  6 Seepage pit  9 Feedyard  12 Fertilizer storage  16 Other (specify below)   
 13 Insecticide storage

Direction from well? Downship from well How many feet? +75

FROM	TO	LITHOLOGIC LOG	FROM	TO	PLUGGING INTERVALS
0	5	earth			
5	65	yellow clay			
65	80	gray shale			
80	90	shaly lime			

7 CONTRACTOR'S OR LANDOWNER'S CERTIFICATION: This water well was  (1) constructed,  (2) reconstructed, or  (3) plugged under my jurisdiction and was completed on (mo/day/year) April 14, 1988 and this record is true to the best of my knowledge and belief. Kansas Water Well Contractor's License No. 4931 This Water Well Record was completed on (mo/day/year) Oct 15, 1988 under the business name of Reiseres Well Drilling by (signature) Jerry Reiser

OFFICE USE ONLY  
T  
R  
EW  
SEC.  
1/4  
1/4  
1/4