

Cowley


MS7 MWIS

1 LOCATION OF WATER WELL: Fraction NE 1/4 SE 1/4 SW 1/4 Section Number 28 Township Number T 30 S Range Number R 4E EW
 County: SUMNER

Distance and direction from nearest town or city street address of well if located within city?
3 MILES ~~WEST~~ OF ~~ROAD~~ ON HIGHWAY 42 MWSB2

2 WATER WELL OWNER: McCONNELL AFB C/O TETRA TECH INC.
 RR#, St. Address, Box #: 10 E. CAMBRIDGE CIR. DR., STE. 130 Board of Agriculture, Division of Water Resources
 City, State, ZIP Code: KANSAS CITY, KS. 66103 Application Number:

3 LOCATE WELL'S LOCATION WITH AN "X" IN SECTION BOX:

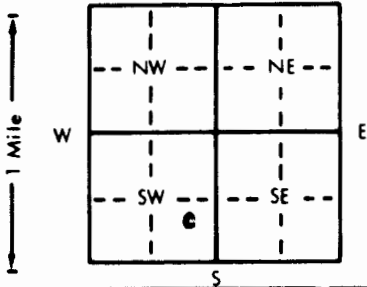

4 DEPTH OF COMPLETED WELL: 74.0 ft. ELEVATION: _____
 Depth(s) Groundwater Encountered: 0 ft. 2. _____ ft. 3. _____ ft.
 WELL'S STATIC WATER LEVEL: 0 ft. below land surface measured on mo/day/yr
 Pump test data: Well water was _____ ft. after _____ hours pumping _____ gpm
 Est. Yield _____ gpm: Well water was _____ ft. after _____ hours pumping _____ gpm
 Bore Hole Diameter: 8.75 in. to 74.0 ft., and _____ in. to _____ ft.
 WELL WATER TO BE USED AS:
 5 Public water supply 8 Air conditioning 11 Injection well
 1 Domestic 3 Feedlot 6 Oil field water supply 9 Dewatering 12 Other (Specify below)
 2 Irrigation 4 Industrial 7 Lawn and garden only Monitoring well
 Was a chemical/bacteriological sample submitted to Department? Yes _____ No _____; If yes, mo/day/yr sample was submitted _____
 Water Well Disinfected? Yes _____ No _____

5 TYPE OF BLANK CASING USED:
 1 Steel 3 RMP (SR) 5 Wrought iron 8 Concrete tile CASING JOINTS: Glued _____ Clamped _____
 PVC 4 ABS 7 Fiberglass _____ Welded _____
 Blank casing diameter: 4" in. to 60.0 ft., Dia _____ in. to _____ ft., Dia _____ in. to _____ ft.
 Casing height above land surface _____ in., weight _____ lbs./ft. Wall thickness or gauge No. .050

TYPE OF SCREEN OR PERFORATION MATERIAL:
 1 Steel 3 Stainless steel 5 Fiberglass 8 RMP (SR) 10 Asbestos-cement
 2 Brass 4 Galvanized steel 6 Concrete tile 9 ABS 11 Other (specify) _____
 12 None used (open hole)

SCREEN OR PERFORATION OPENINGS ARE:
 1 Continuous slot Mill slot 5 Gauzed wrapped 8 Saw cut 11 None (open hole)
 2 Louvered shutter 4 Key punched 6 Wire wrapped 9 Drilled holes
 7 Torch cut 10 Other (specify) _____

SCREEN-PERFORATED INTERVALS: From 60.0 ft. to 70.0 ft., From _____ ft. to _____ ft.
 From _____ ft. to _____ ft., From _____ ft. to _____ ft.
 GRAVEL PACK INTERVALS: From 58.0 ft. to 74.0 ft., From _____ ft. to _____ ft.
 From _____ ft. to _____ ft., From _____ ft. to _____ ft.

6 GROUT MATERIAL: Neat cement 2 Cement grout Bentonite Other 3/8" HOLE PLUG
 Grout Intervals: From 0.0 ft. to 30.0 ft., From 30.0 ft. to 53.0 ft., From 53.0 ft. to 58.0 ft.

What is the nearest source of possible contamination:
 1 Septic tank 4 Lateral lines 7 Pit privy 10 Livestock pens 14 Abandoned water well
 2 Sewer lines 5 Cess pool 8 Sewage lagoon 11 Fuel storage 15 Oil well/Gas well
 3 Watertight sewer lines 6 Seepage pit 9 Feedyard 12 Fertilizer storage 16 Other (specify below)
 13 Insecticide storage _____
 Direction from well? _____ How many feet? _____

FROM	TO	LITHOLOGIC LOG	FROM	TO	PLUGGING INTERVALS
0.0	17.0	TAN & GRAY SHALE & LIMESTONE - DRY / WEATHERED			
17.0	34.0	TAN SHALE W/ LIMESTONE - DRY / WEATHERED			
34.0	74.0	GRAY LIMESTONE - DRY / HARD			

7 CONTRACTOR'S OR LANDOWNER'S CERTIFICATION: This water well was constructed, (2) reconstructed, or (3) plugged under my jurisdiction and was completed on (mo/day/year) 10-12-95 and this record is true to the best of my knowledge and belief. Kansas Water Well Contractor's License No. 551 This Water Well Record was completed on (mo/day/yr) 11-95 under the business name of ASSOCIATED ENVIRONMENTAL INDUSTRIES by (signature) _____

OFFICE USE ONLY
T
R
EW
SEC.