


Cowley

MS7-MWS

1 LOCATION OF WATER WELL: Fraction NE 1/4 SE 1/4 SW 1/4 Section Number 28 Township Number T 30 S Range Number R 4E E/W
 County: SUMNER

Distance and direction from nearest town or city street address of well if located within city?
2 MILES SOUTH OF ~~XXX~~ ON HIGHWAY 77 MWSB-3

2 WATER WELL OWNER: McCONNELL AFB 40 TETRA TECH INC
 RR#, St. Address, Box #: 10 E. CAMBRIDGE CIR. DR. STE. 130 Board of Agriculture, Division of Water Resources
 City, State, ZIP Code: KANSAS CITY, KS 66103 Application Number:

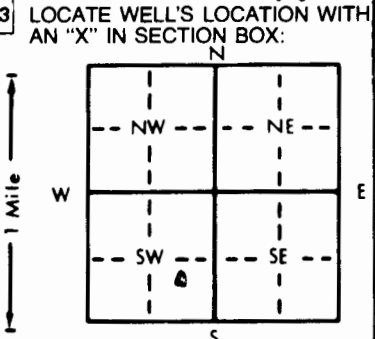

4 DEPTH OF COMPLETED WELL: 17.5 ft. ELEVATION:
 Depth(s) Groundwater Encountered 1. 9.5 ft. 2. ft. 3. ft.
 WELL'S STATIC WATER LEVEL 9.5 ft. below land surface measured on mo/day/yr
 Pump test data: Well water was ft. after hours pumping gpm
 Est. Yield gpm: Well water was ft. after hours pumping gpm
 Bore Hole Diameter: 8.75 in. to 17.5 in. and in. to in. to in. to in. to
 WELL WATER TO BE USED AS: 5 Public water supply 8 Air conditioning 11 Injection well
 1 Domestic 3 Feedlot 6 Oil field water supply 9 Dewatering 12 Other (Specify below)
 2 Irrigation 4 Industrial 7 Lawn and garden only Monitoring well
 Was a chemical/bacteriological sample submitted to Department? Yes No; If yes, mo/day/yr sample was submitted
 Water Well Disinfected? Yes No

5 TYPE OF BLANK CASING USED: 5 Wrought iron 8 Concrete tile CASING JOINTS: Glued Clamped
 1 Steel 3 RMP (SR) 6 Asbestos-Cement 9 Other (specify below) Welded
 PVC 4 ABS 7 Fiberglass Threaded
 Blank casing diameter 4" in. to 6.5 ft., Dia. in. to in. to in. to in. to in. to in. to
 Casing height above land surface in., weight lbs./ft. Wall thickness or gauge No. sch 40
 TYPE OF SCREEN OR PERFORATION MATERIAL: PVC 10 Asbestos-cement
 1 Steel 3 Stainless steel 5 Fiberglass 8 RMP (SR) 11 Other (specify)
 2 Brass 4 Galvanized steel 6 Concrete tile 9 ABS 12 None used (open hole)
 SCREEN OR PERFORATION OPENINGS ARE: 5 Gauzed wrapped 8 Saw cut 11 None (open hole)
 1 Continuous slot Mill slot 6 Wire wrapped 9 Drilled holes
 2 Louvered shutter 4 Key punched 7 Torch cut 10 Other (specify)
 SCREEN-PERFORATED INTERVALS: From 6.5 ft. to 16.5 ft., From ft. to ft. to ft. to ft.
 GRAVEL PACK INTERVALS: From 4.0 ft. to 17.0 ft., From ft. to ft. to ft. to ft.
SAND PACK From 17.0 ft. to 17.5 ft., From ft. to ft. to ft. to ft.

6 GROUT MATERIAL: Neat cement 2 Cement grout 3 Bentonite Other 3/8" HOLE PLUG
 Grout Intervals: From 0.0 ft. to 1.0 ft., From 1.0 ft. to 4.0 ft., From ft. to ft. to ft. to ft.
 What is the nearest source of possible contamination:
 1 Septic tank 4 Lateral lines 7 Pit privy 10 Livestock pens 14 Abandoned water well
 2 Sewer lines 5 Cess pool 8 Sewage lagoon 11 Fuel storage 15 Oil well/Gas well
 3 Watertight sewer lines 6 Seepage pit 9 Feedyard 12 Fertilizer storage 16 Other (specify below)
 13 Insecticide storage

FROM	TO	LITHOLOGIC LOG	FROM	TO	PLUGGING INTERVALS
0.0	6.5	BROWN CLAY -MOIST FILL MATERIAL			
6.5	17.5	TAN LIMESTONE -WEATHERED/MED. HARD -WET AT 10.0			

7 CONTRACTOR'S OR LANDOWNER'S CERTIFICATION: This water well was (1) constructed, (2) reconstructed, or (3) plugged under my jurisdiction and was completed on (mo/day/year) 10-11-95 and this record is true to the best of my knowledge and belief. Kansas Water Well Contractor's License No. 551 This Water Well Record was completed on (mo/day/yr) 1-15-96 under the business name of ASSOCIATED ENVIRONMENTAL INDUSTRIES by (signature) [Signature]

OFFICE USE ONLY
T
R
EW
SEC.
1/4
1/4
1/4