


1 LOCATION OF WATER WELL: Fraction SW 1/4 NE 1/4 SW 1/4 Section Number 28 Township Number T 30 S Range Number R 4 E
 County: Cowley

Distance and direction from nearest town or city street address of well if located within city?
2 miles south of Rock, KS on Highway 77, 1/2 mile East

2 WATER WELL OWNER: McConnell Air Force Base 40 Tetra Tech, Inc.
 RR#, St. Address, Box #: 10 E. Cambridge Cir. Board of Agriculture, Division of Water Resources
 City, State, ZIP Code: Rock, KS (Missile Site #7) Kansas City, KS Application Number:

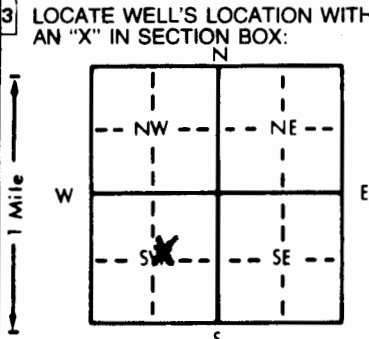

4 DEPTH OF COMPLETED WELL: 85.0 ft. ELEVATION:
 Depth(s) Groundwater Encountered 1. 70.0 ft. 2. — ft. 3. — ft.
 WELL'S STATIC WATER LEVEL: — ft. below land surface measured on mo/day/yr
 Pump test data: Well water was — ft. after — hours pumping — gpm
 Est. Yield — gpm: Well water was — ft. after — hours pumping — gpm
 Bore Hole Diameter: 15.0 in. to 10.0 ft., and 8.75 in. to 85.0 ft.
 WELL WATER TO BE USED AS:
 5 Public water supply 8 Air conditioning 11 Injection well
 1 Domestic 3 Feedlot 6 Oil field water supply 9 Dewatering 12 Other (Specify below)
 2 Irrigation 4 Industrial 7 Lawn and garden only 10 Monitoring well
 Was a chemical/bacteriological sample submitted to Department? Yes — No —; If yes, mo/day/yr sample was submitted
 Water Well Disinfected? Yes — No —

5 TYPE OF BLANK CASING USED:
 1 Steel 3 RMP (SR) 5 Wrought iron 8 Concrete tile CASING JOINTS: Glued — Clamped —
2 PVC 4 ABS 6 Asbestos-Cement 9 Other (specify below) Welded —
 7 Fiberglass Threaded X
 Blank casing diameter 4.0" in. to 10.0" ft., Dia — in. to — ft., Dia — in. to — ft.
 Casing height above land surface: 36" in., weight 800 lbs./ft. Wall thickness or gauge No. Schedule 40
 TYPE OF SCREEN OR PERFORATION MATERIAL:
 1 Steel 3 Stainless steel 5 Fiberglass 7 PVC 10 Asbestos-cement
 2 Brass 4 Galvanized steel 6 Concrete tile 9 ABS 11 Other (specify) —
 12 None used (open hole)
 SCREEN OR PERFORATION OPENINGS ARE:
 1 Continuous slot 3 Mill slot .020 5 Gauzed wrapped 8 Saw cut 11 None (open hole)
 2 Louvered shutter 4 Key punched 6 Wire wrapped 9 Drilled holes
 7 Torch cut 10 Other (specify) —
 SCREEN-PERFORATED INTERVALS: From 70.0' ft. to 80.5' ft., From —' ft. to —' ft., From —' ft. to —' ft.
Filter
 SCHEDULE PACK INTERVALS: From 66.0' ft. to 85.0' ft., From —' ft. to —' ft., From —' ft. to —' ft.
10/20 Silica

6 GROUT MATERIAL: 1 Neat cement 2 Cement grout 3 Bentonite 4 Other —
 Grout Intervals: From 0.0' ft. to 30.0' ft., From 30.0' ft. to 66.0' ft., From —' ft. to —' ft.
 What is the nearest source of possible contamination:
 1 Septic tank 4 Lateral lines 7 Pit privy 10 Livestock pens 14 Abandoned water well ?
 2 Sewer lines 5 Cess pool 8 Sewage lagoon 11 Fuel storage 15 Oil well/Gas well
 3 Watertight sewer lines 6 Seepage pit 9 Feedyard 12 Fertilizer storage 16 Other (specify below)
 13 Insecticide storage
 Direction from well? Southwest How many feet? 100'

FROM	TO	LITHOLOGIC LOG	FROM	TO	PLUGGING INTERVALS
0.0'	12.0'	Clay Mixed with Cement Lime			
12.0'	85.0'	Lime, Cemented Sand + Limestone			

7 CONTRACTOR'S OR LANDOWNER'S CERTIFICATION: This water well was (1) constructed, (2) reconstructed, or (3) plugged under my jurisdiction and was completed on (mo/day/year) 11/14/97 and this record is true to the best of my knowledge and belief. Kansas Water Well Contractor's License No. 551 This Water Well Record was completed on (mo/day/yr) 11/21/97 under the business name of Associated Environmental Ind., Corp. by (signature) Robert C. Reyes

OFFICE USE ONLY